


CERTIFIED RECORD OF LAND CORNER MONUMENTATION

History of original corner establishment:

None

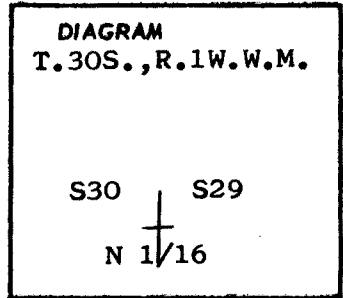


Description of corner evidence found:

None

Description of monument and accessories I established to perpetuate the original location of this corner

I set a 2"X30" I.P. with brass cap.

I stamped the disc. →

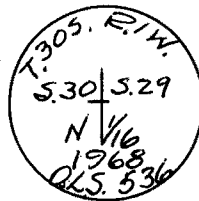

From the pipe monument the ne@ bearing trees are:

a 10" fir bears N.66°W. 10.4 ft. scribed N 1/16 S30 BT

a 22" fir bears N.41°E. 32.5 ft. scribed N 1/16 S29 BT

I also placed USFS bearing tree signs on both trees, breast high and facing the pipe monument

Office of Surveyor..... County of Douglas

State of Oregon....., I hereby certify that the within instrument was filed in this office for record on the 12 day of July....., 19 68, at 4 o'clock P.m., (signed)

James W. Ryan by..... (COUNTY OFFICIAL) (DEPUTY)