


CERTIFIED RECORD OF LAND CORNER MONUMENTATION

History of original corner establishment:

None

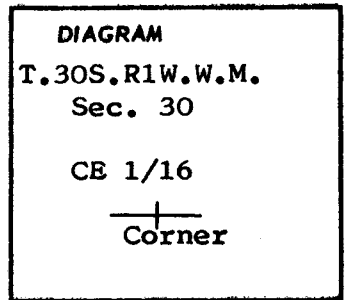


Description of corner evidence found:

None

Description of monument and accessories I established to perpetuate the original location of this corner

I set 2"X30" I.P. with brass cap

I stamped the disc.

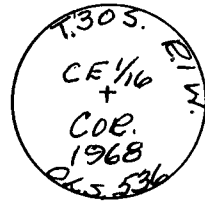

From the pipe monument the new bearing trees are.  
 a 10" cedar bears N.60°E. 58.5 ft. scribed CE 1/16 S.30 BT  
 a 11" cedar bears S.5°E. 26.0 ft. scribed CE 1/16 S.30 BT  
 I also placed USFS bearing tree signs on both trees, breast high and facing the pipe monument.

Office of... Surveyor ..... County of... Douglas .....  
 State of... Oregon ..... I hereby certify that the within instrument was filed in this office  
 for record on the... 12... day of... July ..... 19... 68, at... 4... o'clock... p... m., (signed)  
James W. Raymond by .....  
 (COUNTY OFFICIAL) (DEPUTY)