


CERTIFIED RECORD OF LAND CORNER MONUMENTATION

History of original corner establishment:

None

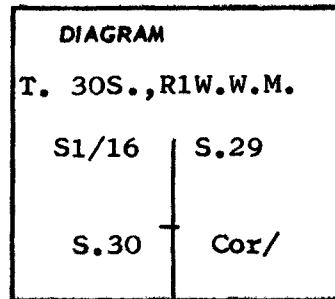


Description of corner evidence found:

NONE

Description of monument and accessories I established to perpetuate the original location of this corner

I set a 2"X30" I.P. with brass cap.

I stamped the disc

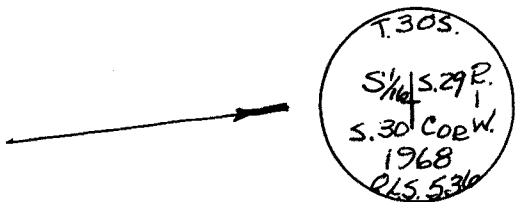

From the pipe monument the new bearing trees are:

a 12" Madrone bears N.40°E 9.3 ft. scribed S 1/16 S29 BT

a 16" Madrone bears S63°W. 34.6 ft. scribed S 1/16 S 30 BT

I also placed USFS bearing tree signs on both trees breast high and facing the pipe monument

Office of Surveyor County of Douglas
 State of Oregon, I hereby certify that the within instrument was filed in this office
 for record on the 12 day of July, 1968, at 4 o'clock p.m., (signed)
James W. Byrum by _____
 (COUNTY OFFICIAL) (DEPUTY)