


CERTIFIED RECORD OF LAND CORNER MONUMENTATION

History of original corner establishment:

None

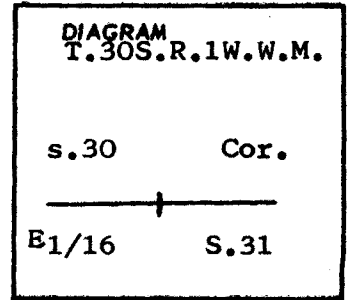


Description of corner evidence found:

NONE

Description of monument and accessories I established to perpetuate the original location of this corner

I set a 2"X30" I.P. with brass cap

I stamped the disc

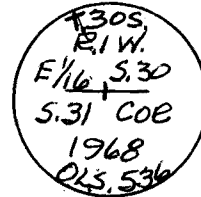

From the pipe monument the new bearing trees are.

a 6" alder bears S.63°E. 29.5 ft. scribed E 1/16 S.31 B.T.

a 4" fir bears S.82°W. 5.5 ft. scribed E 1/16 S. 31 B.T.

I also placed USFS bearing tree signs on both trees breast high and facing the monument.

Office of Surveyor County of Douglas
 State of Oregon, I hereby certify that the within instrument was filed in this office
 for record on the 12 day of July, 1968, at 4 o'clock p.m., (signed)
Jessie W. Ryan by _____
 (COUNTY OFFICIAL) (DEPUTY)