

T26S R6S


T26S R5W

COUNTY SURVEYORS FILE DATA  
DO NOT REMOVE FROM OFFICE

FILED *[Signature]*  
RECEIVED

JUL 7 1969

COUNTY SURVEYOR  
DOUGLAS COUNTY, ORE.

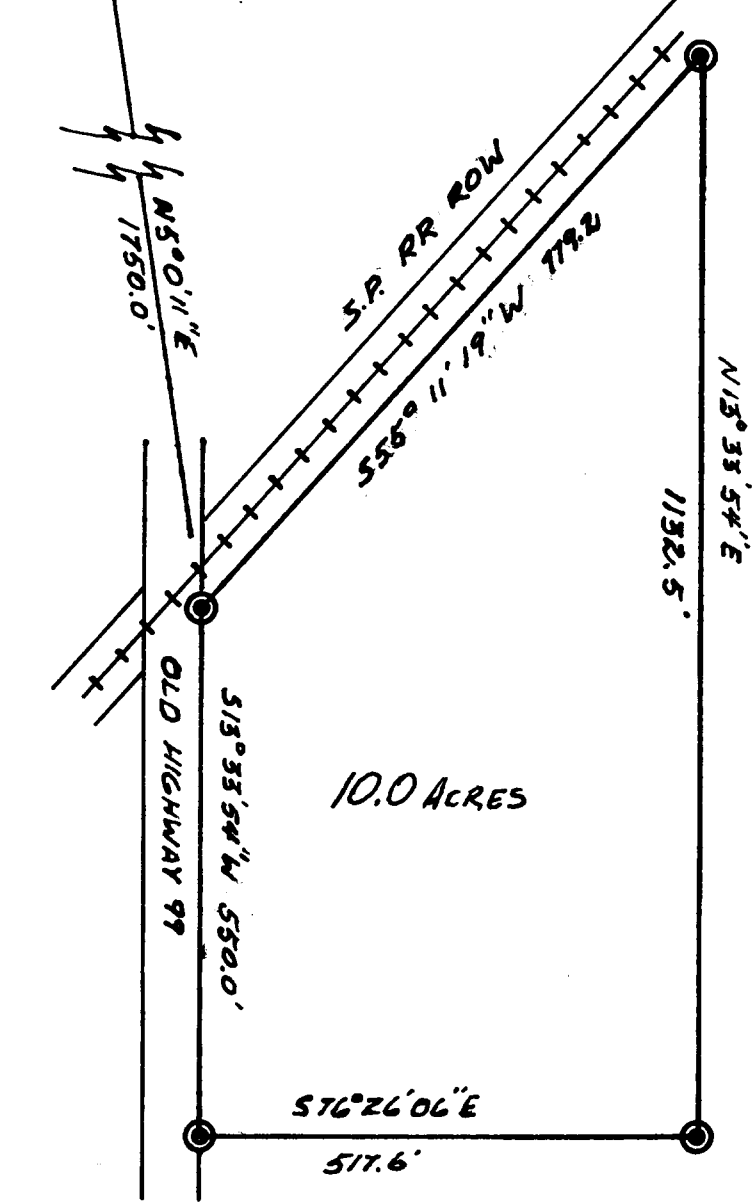

10.0 ACRES

REGISTERED  
OREGON  
LAND SURVEYOR

*William C. Stiles*

OCT. 4, 1957  
WILLIAM C. STILES  
432

SURVEYED FOR JACKSON RANCH INC.  
SEEK INC.

SCALE - 1" = 200'

JULY 3, 1969

BEARINGS BASED ON SOLAR OBSERVATION



CORNER FOUND - "  
CORNER SET - 5/8 IRON ROD