


CERTIFIED RECORD OF LAND CORNER MONUMENTATION

History of original corner establishment:

Dependent resurvey of the East Bdy. T, 32 S., R3W.
As surveyed by Fred Mensch, under special instruction dated August, 1912.

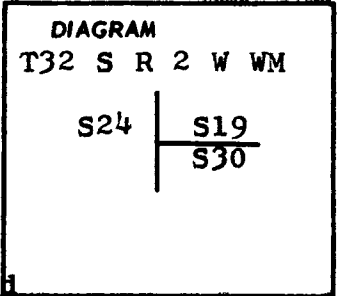

Original survey states: Intersect the old cor. of secs. 19, 24, 25 and 30, which is a stone, firmly set marked and witnessed as described by the surveyor General and which I now change to refer to secs 19 and 30, T. 32 S., R. 2 W., only and destroy marks on bearing trees referring to R. 3 W. The remaining bearing trees are:
 A fir, 24 ins. diam, bears N 52½* E., 7 lks dist.
 Marked T 32 S R 2 W S 19 B T.
 A fir, 16 ins. diam., bears S 15* E., 8 lks, dist.
 Marked T 32 S R 2 W S 30 B T


Description of corner evidence found:

A stone 24"x12"x5" with 2 notches on soth and 4 notches on north edges
 A fir, 34 ins. diam, bears N 52* E, with scribes in poor condition

Description of monument and accessories I established to perpetuate the original location of this corner

Using record bearing and distance, I set a 2" by 30" galvanized iron pipe, with brass cap, 24" in the ground, and placed the stone alongside.

I stamped the disk

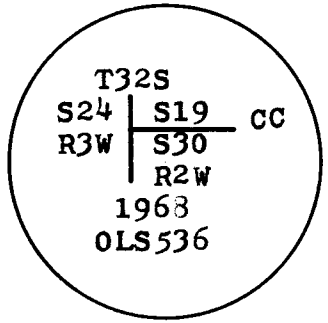

From iron pipe monument, I marked:
 A fir, 22 ins. diam, bears S 38* E 22.5'
 Marked T 32 S R 2 W S 30 B T

 A fir, 34 ins. diam., bears N 52* E 4.0'
 Re-marked T 32 S R 2 W S 19 B T

**REGISTERED
OREGON
LAND SURVEYOR**

Glenn S. Baughman
JULY 14, 1961
GLENN S. BAUGHMAN
536

I placed bearing tree tags on all bearing trees and facing the monument.

Office of Surveyor County of Douglas
 State of Oregon, I hereby certify that the within instrument was filed in this office for record on the 23 day of August, 19 68, at 10 o'clock A.m., (signed)
James E. Ryan by _____
 (COUNTY OFFICIAL) (DEPUTY)

FILED
RECEIVED

AUG 23 1968

COUNTY SURVEYOR
DOUGLAS COUNTY, ORE.
700308 | 100300
#26 Form R6-7100-57 (9/66)

C. S. File No. 55/87-1