


CERTIFIED RECORD OF LAND CORNER MONUMENTATION

History of original corner establishment:

Dependent resurvey of the East Bdy. T32S R3W, as surveyed by Fred Mensch under special instructions dated Aug. 1912

States: Intersect the cor of secs, 18 and 19, T32S R2W., which is a stone (an ironstone 24x15x8 ins. marked with 3 notchs on North and South edges.) marked and witnessed as described by the Surveyor General. As no bearing tree was formerly taken in sec.18, I re-witness this cor. as follows:

- A madrona, 20 ins. dia. bears N46°E., 131 lks.  
Marked T32S R2W S18 BT
- A fir, 48 ins. dia. bears S8°E., 45 lks.  
Marked T32S R2W S19 BT

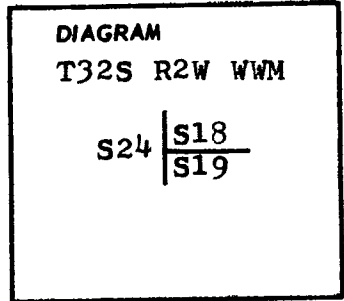

Description of corner evidence found:

an ironstone 24x14x8 ins. with 3 notchs on the North and South edges.

A fir 58 ins. dia. with open face and scribes in good condition bears S8°E 29.7 ft.

Description of monument and accessories I established to perpetuate the original location of this corner

Using the record bearing and distance I set a 2" by 30" galvanized iron pipe, with brass cap, 24" in the ground and placed the stone alongside.

From the pipe monument the original bearing tree is  
A fir 58 ins. dia. bears S8°E 29.7 ft.

I Marked a Madrona 10 ins. dia. bears N41°E 51.3 ft.  
Marked T32S R2W S18 CCBT

REGISTERED  
OREGON  
LAND SURVEYOR

*Glenn S. Baughman*

JULY 14, 1961  
GLENN S. BAUGHMAN  
536

I stamped the disk

T32S  
S24 | S18 CC  
      | S19  
      R2W  
      1968  
      OLS 536

Office of Surveyor..... County of Douglas.....  
 State of Oregon....., I hereby certify that the within instrument was filed in this office  
 for record on the 23 day of August, 1968, at 10 o'clock A.m., (signed)  
*John W. Baughman* by .....  
 (COUNTY OFFICIAL) (DEPUTY)

FILED  
RECEIVED

AUG 23 1968

COUNTY SURVEYOR  
DOUGLAS COUNTY, ORE.

#28 Form R6-7100-57 (9/66)  
#56 T32-3 700374/100400

C. S. File No. 55/87<sup>-2</sup>