

CERTIFIED RECORD OF LAND CORNER MONUMENTATION


History of original corner establishment:

As surveyed by Charles L. Campbell, Deputy Surveyor, under contract No. 747, dated 1902.

Original survey states: A fir, 10 ins. diam., for 1/4 sec. cor., marked 1/4 S 12 on the W. and S 7 on the E. faces, from which

A fir, 12 ins. diam., bears S 60* E., 45 lks. dist. Marked 1/4 S B T.

A fir, 12 ins. diam., bears N 70* W., 13 lks. dist. Marked 1/4 S B T.

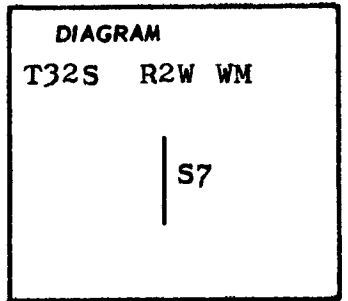

Description of corner evidence found:


A fir, 16 ins. diam., marked 1/4 S7 on east face.

A fir, 16 ins. diam., bears N 62* W 13.7' Marked 1/4 S B T.

Description of monument and accessories I established to perpetuate the original location of this corner

Using record bearing and distances, I set a 2" by 30" galvanized iron pipe, with brass cap, 24" in the ground.

I stamped the disk

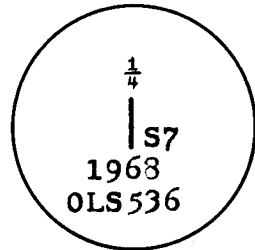

From the pipe monument, the original bearing tree is:

A fir, 16" diam., bears N 62* W 13.7' Marked 1/4 S B T

I marked a fir 20 ins. diam., bears S 59* E 26.0' Marked 1/4 S B T

I placed bearing tree tags on all bearing trees and monument.

REGISTERED OREGON LAND SURVEYOR

Glenn S. Baughman

JULY 14, 1968
GLENN S. BAUGHMAN

Office of SURVEYOR County of Douglas
State of Oregon, I hereby certify that the within instrument was filed in this office
for record on the 23 day of August, 1968, at 10 o'clock AM, (signed)
James W. Ryan by _____
(COUNTY OFFICIAL) (DEPUTY)

FILED
RECEIVED

AUG 23 1968

COUNTY SURVEYOR
DOUGLAS COUNTY, ORE.

Form R6-7100-57 (9/66)

#32 #60-T32-2

700531 / 100524

C. S. File No. 55/87 -4