


CERTIFIED RECORD OF LAND CORNER MONUMENTATION

History of original corner establishment:

As surveyed by Charles L. Campbell, Deputy Surveyor,
Under Contract No. 747, Dated 1902

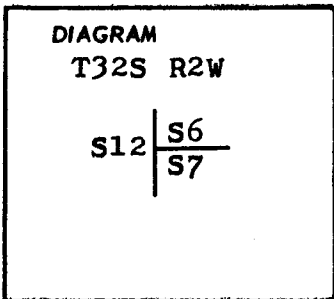

Orig. Survey record states: Set an ironstone,
15x15x5 ins. 10 ins. in ground, for cor. of secs.
1, 6, 7, and 12, marked with 1 noth on the N. and
5 notchs on the S. edges from which:
A fir, 20 ins. dia., bears N.63°E., 29 lks. dist.
A fir, 12 ins. diam., bears S85°E., 43 lks. dist.
A matherone, 12 ins. dia., bears S50° W., 25 lks. dist.
A pine, 18 ins. dia., bears N83°W., 17 lks. dist.

REsurvey by Fred Mensch under contract dated 1904 states:
I distroy marks of former corner bearing trees referring
to sections 1 and 12 T32S R3W WWM

Description of corner evidence found:


Found an ironstone 15x15x5 ins. with 1 notch on the North and
5 notchs on the South edges

Found a 32 inch fir marked T 32 S R2W S6 BT
it bears N61°E 18.5 feet
Found a 26 inch fir marked T32S R2W S7 BT
it bears S86°E 24.5 feet

Description of monument and accessories I established to perpetuate the
original location of this corner

At the position of the stone, I set a 2" by 30" galvanized
iron pipe with a brass, 2 1/4" in the ground and set the original
stone alongside.

I stamped the disk

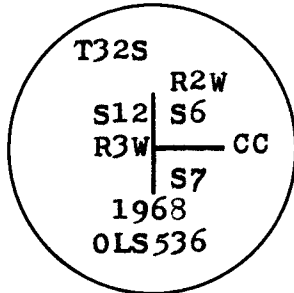

I placed a bearing tree tag on both
trees and facing the monument.

REGISTERED
OREGON
LAND SURVEYOR

Glenn S. Baughman
JULY 14, 1961
GLENN S. BAUGHMAN
536

Office of Surveyor..... County of..... Douglas.....
State of Oregon....., I hereby certify that the within instrument was filed in this office
for record on the 23 day of August....., 19 68, at 10 o'clock A m., (signed)
James H. Taylor by..... (DEPUTY)

FILED
RECEIVED

AUG 23 1968

COUNTY SURVEYOR
DOUGLAS COUNTY, ORE.

Form R6-7100-57 (9/66)

#31 #59 T32-3

70057 100000

C. S. File No. 55/87 -5