


CERTIFIED RECORD OF LAND CORNER MONUMENTATION

History of original corner establishment:

As surveyed by Charles L. Campbell Deputy Surveyor, Under Contract No. 747, Dated 1902

Original survey states: Set an ironstone, 18x12x6 ins. for of secs. 19,20,29,and 30, marked with 2 notchs on South and East edges, from which:
A hemlock, 30 ins. dia., bears N50°E 30 lks.
Marked T32S R2W S20 BT
A hemlock, 20 ins. dia., bears S14°E, 64 lks.
Marked T32S R2W S29 BT
A hemlock, 24 ins. dia., bears S20°W, 29 lks.
Marked T32S R2W S30 BT
A hemlock, 28 ins. dia., bears N6½°W, 63 lks.
Marked T32S R2W S19 BT

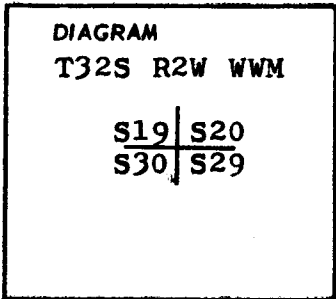

Description of corner evidence found:

A stone 18x12x6 ins. with 2 notchs on South and 5 notchs on the East edges.

- A 28 ins. hemlock with open face, scribes in good condition bears N5°W 29.3 ft.
- A 22inch hemlock with open face, scribes in good condition bears S14°E 42.2 ft.

Description of monument and accessories I established to perpetuate the original location of this corner

at the position of the stone I set a 2" by 30" galvanized iron pipe, with brass cap, 24" in the ground and placed the stone alongside.

I marked the following bearing tree:
A 54 inch fir bears N69°E 29.5 ft.
Marked T32S R2W S20 BT


No other trees were in limits for sec. 30

I placed bearing tree tags on all bearing trees and facing the monument.

REGISTERED
OREGON
LAND SURVEYOR

Glenn S. Baughman
JULY 14, 1968
GLENN S. BAUGHMAN
536

I stamped the disk

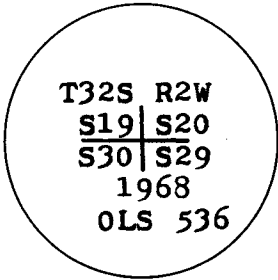

Office of Surveyor County of Douglas
State of Oregon, I hereby certify that the within instrument was filed in this office
for record on the 23 day of August, 19 68, at 10 o'clock am, (signed)
James W. Ryan by _____
(COUNTY OFFICER) (DEPUTY)

FILED
RECEIVED

AUG 23 1968

COUNTY SURVEYOR
DOUGLAS COUNTY, ORE.

Form R6-7100-57 (9/66)

#42

200300

C. S. File No. 55/87⁻⁷