


CERTIFIED RECORD OF LAND CORNER MONUMENTATION

History of original corner establishment:

As surveyed by Charles L. Campbell Deputy Surveyor, Under Contract No. 747 dated 1902

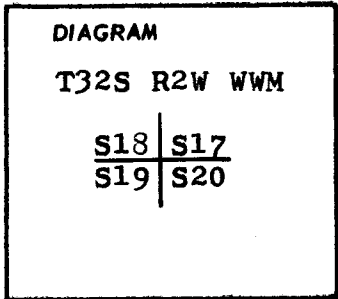

Original survey states: Set an ironstone, 18x10x6 ins for cor. of secs. 17,18,19, and 20, marked with 3 notchs on South and East edges, from which:

- A fir, 36 ins. dia. bears N24½\*E, 11 lks. dist.  
Marked T32S R2W S17 BT
- A fir, 42 ins. dia. bears S69\*E, 52 lks. dist.  
Marked T32S R2W S20 BT
- A fir, 28 ins. dia. bears N19½\*E, 153 lks. dist.  
Marked T32S R2W S18 BT
- No SW tree in limits


Description of corner evidence found:

Found a stone 18x10x6 ins. with 3 notches on the South and 5 notches on the East edges  
A fir snag with good scribes bears N35\*E 7.3 ft.

Description of monument and accessories I established to perpetuate the original location of this corner

At the position of the stone, I set a 2" by 30" galvanized iron pipe with a brass cap, 24" in the ground and set the stone alongside.

I stamped the disk

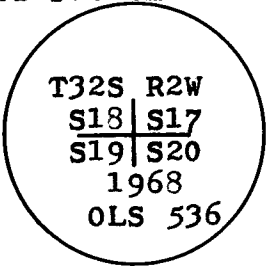

- From the pipe monument I marked a...
- 20" hemlock T32S R2W S17 BT brs N67½\*E 58.0 ft.
  - 8" fir T32S R2W S20 BT bears S22\*E 33.2 ft.
  - 16" fir T32S R2W S19 BT bears S25\*W 47.2 ft.
  - 10" fir T32S R2W S18 BT bears N58\*W 32.0 ft.

I placed bearing tree tags on all bearing trees, and facing the monument.

REGISTERED  
OREGON  
LAND SURVEYOR

*Glenn S. Baughman*  
JULY 14, 1961  
GLENN S. BAUGHMAN  
536

Office of... Surveyor ..... County of... Douglas .....  
State of... Oregon ....., I hereby certify that the within instrument was filed in this office  
for record on the 23 day of August ....., 1968, at 10 o'clock A.m., (signed)  
*James W. Ryan* by .....  
(COUNTY OFFICIAL) (DEPUTY)

FILED  
RECEIVED

AUG 23 1968

COUNTY SURVEYOR  
DOUGLAS COUNTY, ORE.

#39 Form R6-7100-57 (9/66)

200400

C. S. File No. 55/87