


CERTIFIED RECORD OF LAND CORNER MONUMENTATION

History of original corner establishment:

As surveyed by Charles L. Campbell Deputy Surveyor, Under Contract No. 747, Dated 1902

Original survey states: Set a granite stone, 24x12x5 ins. for $\frac{1}{4}$ sec. cor., Marked on the North face with $\frac{1}{4}$, from which :

- A fir, 28 ins. dia., bears S30*W, 45 lks.
Marked $\frac{1}{4}$ S20 BT
- A sugar pine, 30 ins. dia., bears N10*W., 32 lks.
Marked $\frac{1}{4}$ S17 BT

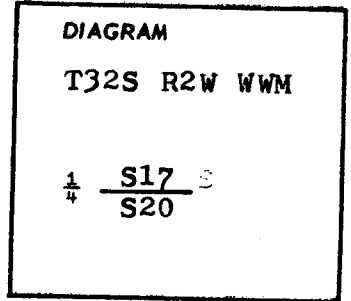


Description of corner evidence found:

- A fir, 36 ins. dia., bears S30*W 28.3 ft.
With closed face
- A sugar pine, 40 ins. dia., bears N10*W, 20.1 ft.
I opened the face and found scribes in good condition
- A stone 24x12x5, marked $\frac{1}{4}$ on the North face

Description of monument and accessories I established to perpetuate the original location of this corner

Using record bearings and distances I set a 2" by 30" galvanized iron pipe, with brass cap, 24" in the ground and placed the stone alongside.

I stamped the disk

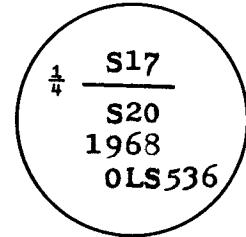

I placed bearing tree tags on all bearing trees and facing the monument.

REGISTERED
OREGON
LAND SURVEYOR

Glenn S. Daughman
JULY 14, 1968
GLENN S. DAUGHMAN
SSS

Office of Surveyor County of Douglas
State of Oregon , I hereby certify that the within instrument was filed in this office
for record on the 23 day of August , 1968, at 10 o'clock A. m., (signed)
James W. Ryan by
(COUNTY OFFICIAL) (DEPUTY)

FILED
RECEIVED

AUG 23 1968

COUNTY SURVEYOR
DOUGLAS COUNTY, ORE.

#38 Form R6-7100-57 (9/66)
240400

C. S. File No. 55/87-9