

CERTIFIED RECORD OF LAND CORNER MONUMENTATION

History of original corner establishment:

As surveyed by Charles L. Campbell Under Contract No. 747 Dated 1902

Original survey states: Set a basalt stone, 12x12x8 ins., for cor cor of secs. 13,17,20,and 21, marked with 3 notches on the South and 4 notches on the East edges, from which:


A fir, 34 ins. dia., bears N80°E., 184 lks.

Marked T32S R2W S16 BT

A fir, 30 ins. dia., bears N89 3/4°W., 298 lks.

Marked T32S R2W S17 BT

No other trees in limits. Raise mound of stone, 2 ft. base 1 1/2 ft. high, West of cor.

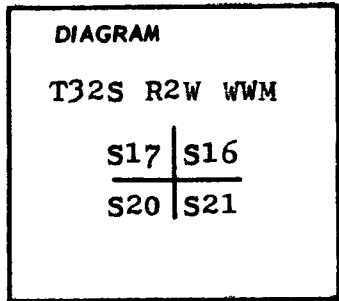

Description of corner evidence found:


A stone well eroded

A fir 40 ins. dia., with open face, bears N80°E 121.4 ft.

Description of monument and accessories I established to perpetuate the original location of this corner

Using the record bearings and distances from the bearing tree I set a 2" by 30" galvanized iron pipe, with brass cap, 24" in the ground and placed the stone alongside.

I stamped the disk

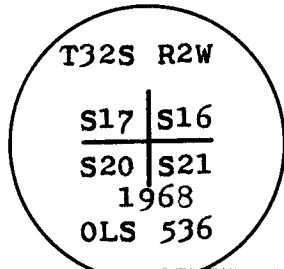

From the pipe monument I Marked:

A fir 12 ins. dia. bears N27°E 11.6 ft.

Marked T32S R2W S16 BT

A fir 13 ins. dia. bears S41°E 44.7 ft.

Marked T32S R2W S21 BT

A fir 15 ins. dia. bears S18°W 43.8 ft.

Marked T32S R2W S20 BT

A fir 15 ins. dia. bears N42°W 9.9 ft.

Marked T32S R2W S17 BT

I placed bearing tree tags on all bearing trees and facing the monument.

REGISTERED
 OREGON
 LAND SURVEYOR

Glenn S. Baughman

JULY 14, 1961
 GLENN S. BAUGHMAN
 536

Office of Surveyor County of Douglas
 State of Oregon, I hereby certify that the within instrument was filed in this office
 for record on the 23 day of August, 1968, at 10 o'clock A.m., (signed)
James R. Ryan by _____
 (COUNTY OFFICIAL) (DEPUTY)

FILED
 RECEIVED

AUG 23 1968

COUNTY SURVEYOR
 DOUGLAS COUNTY, ORE.

#36 Form R6-7100-57 (9/66)
 300400

C. S. File No. 56/87 -12