

CERTIFIED RECORD OF LAND CORNER MONUMENTATION

History of original corner establishment:

As surveyed by Charles L. Campbell Deputy Surveyor, Under Contract No. 747, Dated 1902

Original survey states:


Set an ironstone, 18x12x6 ins. for $\frac{1}{4}$ sec. cor. marked $\frac{1}{4}$ on West face, from which:

A fir, 10 ins. dia., bears S15°E, 23 lks. dist.

Marked $\frac{1}{4}$ S21 BT

A fir, 14 ins. dia. bears S19 $\frac{1}{2}$ °W, 48 lks. dist.

Marked $\frac{1}{4}$ S20 BT

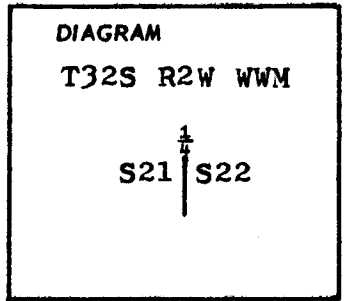

Description of corner evidence found:


A stone 18x12x6 ins. marked $\frac{1}{4}$ on West face

A 24 ins. fir with scribes in poor condition bears S24°W 31.0 ft.

Description of monument and accessories established to perpetuate the original location of this corner

At the position of the stone I set a 2" by 30" galvanized iron pipe, with a brass cap, 24" in the ground and placed the stone alongside.

I stamped the disk

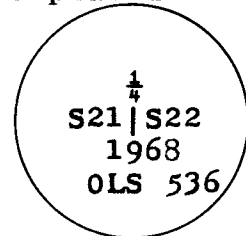

From the pipe monument I marked:

A 15 inch white fir bears N68°E 20.7 ft.

Marked $\frac{1}{4}$ S22 BT

And remarked a 24 inch fir bearing S24°W 31.0 ft.

Marked $\frac{1}{4}$ S21 BT

I placed bearing tree tags on all bearing trees and facing the monument



Office of Surveyor County of Douglas
 State of Oregon, I hereby certify that the within instrument was filed in this office
 for record on the 23 day of August; 19 68, at 10 o'clock A.m., (signed)
James W. Ryan by _____
 (COUNTY OFFICIAL) (DEPUTY)

FILED
RECEIVED

AUG 23 1968

COUNTY SURVEYOR
DOUGLAS COUNTY, ORE.

Form R6-7100-57 (9/66)

460340

C. S. File No. 55/87-14