


CERTIFIED RECORD OF LAND CORNER MONUMENTATION

History of original corner establishment:

Dependent resurvey of the East bdy. T, 32 S. R3W.
As surveyed by Fred Mensch, under special instruction dated August, 1912.

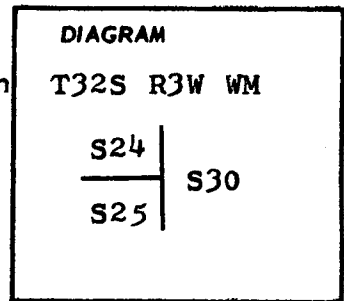

Original survey states: Set a granite stone, 15x12x6 ins., 10 ins. in ground, for cor. of secs. 24 and 25 only, marked with 2 notches on S. and 4 notches on N. edge, from which:

- A sugar pine, 12 ins. diam., bears S 82* W 25 lks. Marked T 32 S R 3 W S 25 B T
- A fir, 12 ins. diam., bears N. 60* W., 45 lks, dist. Marked T 32 S R 3 W S 24 B T.

Description of corner evidence found:


A stone 15"x12"x6" with 2 notches on south and 4 notches on north edges.

- A fir, 24 ins. diam., bears N 60*W, 29.7'
Marked T 32 S R 3 W S 24 B T
- A sugar pine, 24 ins. diam. with closed face, bears S 82* W, 16.5'

Description of monument and accessories I established to perpetuate the original location of this corner

At the position of the stone, I set a 2" by 30" galvanized iron pipe, with brass cap, 24" in the ground, and placed the stone alongside.

I stamped the disk

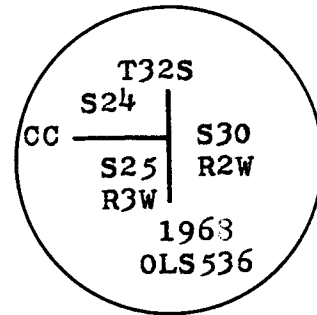

From the pipe monument, the original bearing trees are:

- A fir, 24 ins. diam., bears N. 60* W 29.7'
Marked T 32 S R 3 W S 24 B T
- A sugar pine, 24 ins, diam., bears S 82* W 16.5'
Remarked T 32 S R 3 W S 25 C C B T

**REGISTERED
OREGON
LAND SURVEYOR**

Glenn S. Baughman
JULY 14, 1961
GLENN S. BAUGHMAN
536

I placed bearing tree tags on all bearing trees and facing the monument.

Office of Surveyor County of Douglas
State of Oregon, I hereby certify that the within instrument was filed in this office
for record on the 23 day of August, 1968, at 10 o'clock 1 m., (signed)
Glenn S. Baughman by _____ (DEPUTY)
(COUNTY OFFICIAL)

**FILED
RECEIVED**

AUG 23 1968

COUNTY SURVEYOR
DOUGLAS COUNTY, ORE.

#27 Form R6-7100-57 (9/66)

#55 T32-3

700 300 100 212

C. S. File No. 55/87-17