


CERTIFIED RECORD OF LAND CORNER MONUMENTATION

History of original corner establishment:

Dependent resurvey of the East Bdy. T, 32 S., R 3 W as surveyed by Fred Mensch, under special instructions dated August, 1912.

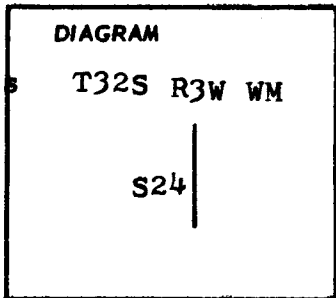

Original survey states: Set a slate stone, 18x12x4 ins., 12 ins. in ground, for $\frac{1}{4}$ sec. cor. of sec. 24 only, marked $\frac{1}{4}$ on W. face, from which

A madrona, 12 ins. diam., bears S 36* W., 83 lks. Marked $\frac{1}{4}$ S 24 B T.

A fir, 6 ins. diam., bears N 34* W., 40 lks dist. Marked $\frac{1}{4}$ S 24 B T.

Description of corner evidence found:


A stone 18" x 12" x 4" marked $\frac{1}{4}$ on west face

A 20" madrona with open face scribes in poor condition bears S 36* W 54.9'

Description of monument and accessories I established to perpetuate the original location of this corner

Using record bearing and distance I set a 2" by 30" galvanized iron pipe, with brass cap, 24" in the ground and placed the stone alongside.

I stamped the disk

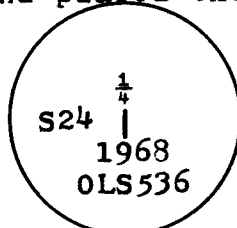

From the pipe monument, I marked the following trees:

A fir, 27 ins. diam., bears N 33* W 25.5'
Marked $\frac{1}{4}$ S 24 B T

A fir, 12 ins. diam., bears S 6* E 15.3'
Marked $\frac{1}{4}$ S 24 B T

I placed bearing tree tags on all bearing trees and facing the monument.

REGISTERED
OREGON
LAND SURVEYOR

Glenn S. Baughman

JULY 14 1961
GLENN S. BAUGHMAN
536

Office of Surveyor County of Douglas
 State of Oregon, I hereby certify that the within instrument was filed in this office
 for record on the 23 day of August, 1968, at 10 o'clock A m., (signed)
James W. [Signature] by _____
 (COUNTY OFFICIAL) (DEPUTY)

FILED
RECEIVED

AUG 23 1968

COUNTY SURVEYOR
DOUGLAS COUNTY, ORE.

Form R6-7100-57 (9/66)

#24 #52-T32-3 700210/100301

C. S. File No. 55/87-18