


CERTIFIED RECORD OF LAND CORNER MONUMENTATION

History of original corner establishment:

Resurvey of portions of east bdy., T32S., R3W  
As surveyed by Fred Mensch, under contract No. 757  
dated Sept. 14, 1904.

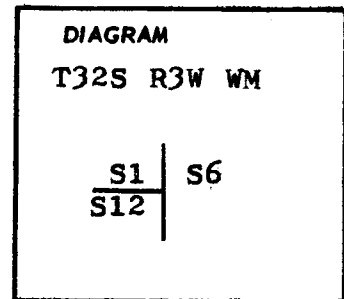

Original survey states: Set a granite stone, 18x14x4 ins., 12 ins. in the ground, for closing corner of Secs. 1 and 12, marked CC on W, with 1 groove on N. and 5 grooves on S. face, from which

- A Pine, 9 ins. diam., bears N 80\* W 84 lks. dist., marked T 32 S R 3 W S 1 B T.
- A Red Fir, 20 ins. diam., bears S 23\* W., 86 lks. dist., marked T 32 S R 3 W S 12 B T.

Description of corner evidence found:

A stone 18"x14"x4" marked with 1 notch on north and 5 notches on south faces  
Also an axel 1 1/2" x 30"  
A fir, 16 ins. diam., with open face scribes in good condition, bears N 3\* W 6.8'  
A fir, 12 ins. diam., with closed face, bears S 84\* W 14.6'


REGISTERED  
OREGON  
LAND SURVEYOR

*Glenn S. Baughman*  
JULY 14, 1961  
GLENN S. BAUGHMAN  
536

Description of monument and accessories I established to perpetuate the original location of this corner

At the position of the stone and axel, I set a 2" by 30" galvanized iron pipe, with brass cap, 24" in the ground, and placed the stone and axel alongside.

I stamped the disk

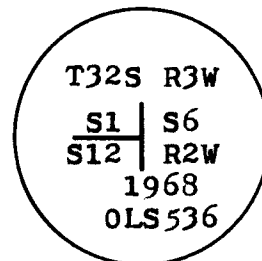

From the pipe monument, the bearing trees are:  
A fir, 16 ins. diam., bears N 3\* W 6.8'

A fir, 12 ins. diam., bears S 84\* W 14.6'

I placed bearing tree tags on all bearing trees and facing the monument.

Office of Surveyor County of Douglas  
State of Oregon, I hereby certify that the within instrument was filed in this office  
for record on the 23 day of August, 1968, at 10 o'clock A m., (signed)  
*John W. Ryan* by \_\_\_\_\_ (DEPUTY)  
(COUNTY OFFICIAL)

FILED  
RECEIVED

AUG 23 1968

COUNTY SURVEYOR  
DOUGLAS COUNTY, ORE.

#30 Form R6-7100-57 (9/66)

#58-732-3

700000/100000

C. S. File No. 55/87-20