


SURVEYED FOR DEED DESCRIPTION

LOCATED IN SEC. 32, T.25S., R.6 W.W.M.
SURVEYED FOR LESTER RICHARDSON
BY BAUGHMAN & ACKERET INC. DEC. 1968

5/9

COUNTY SURVEYORS FILE DATA
~~DO~~ NOT REMOVE FROM OFFICE

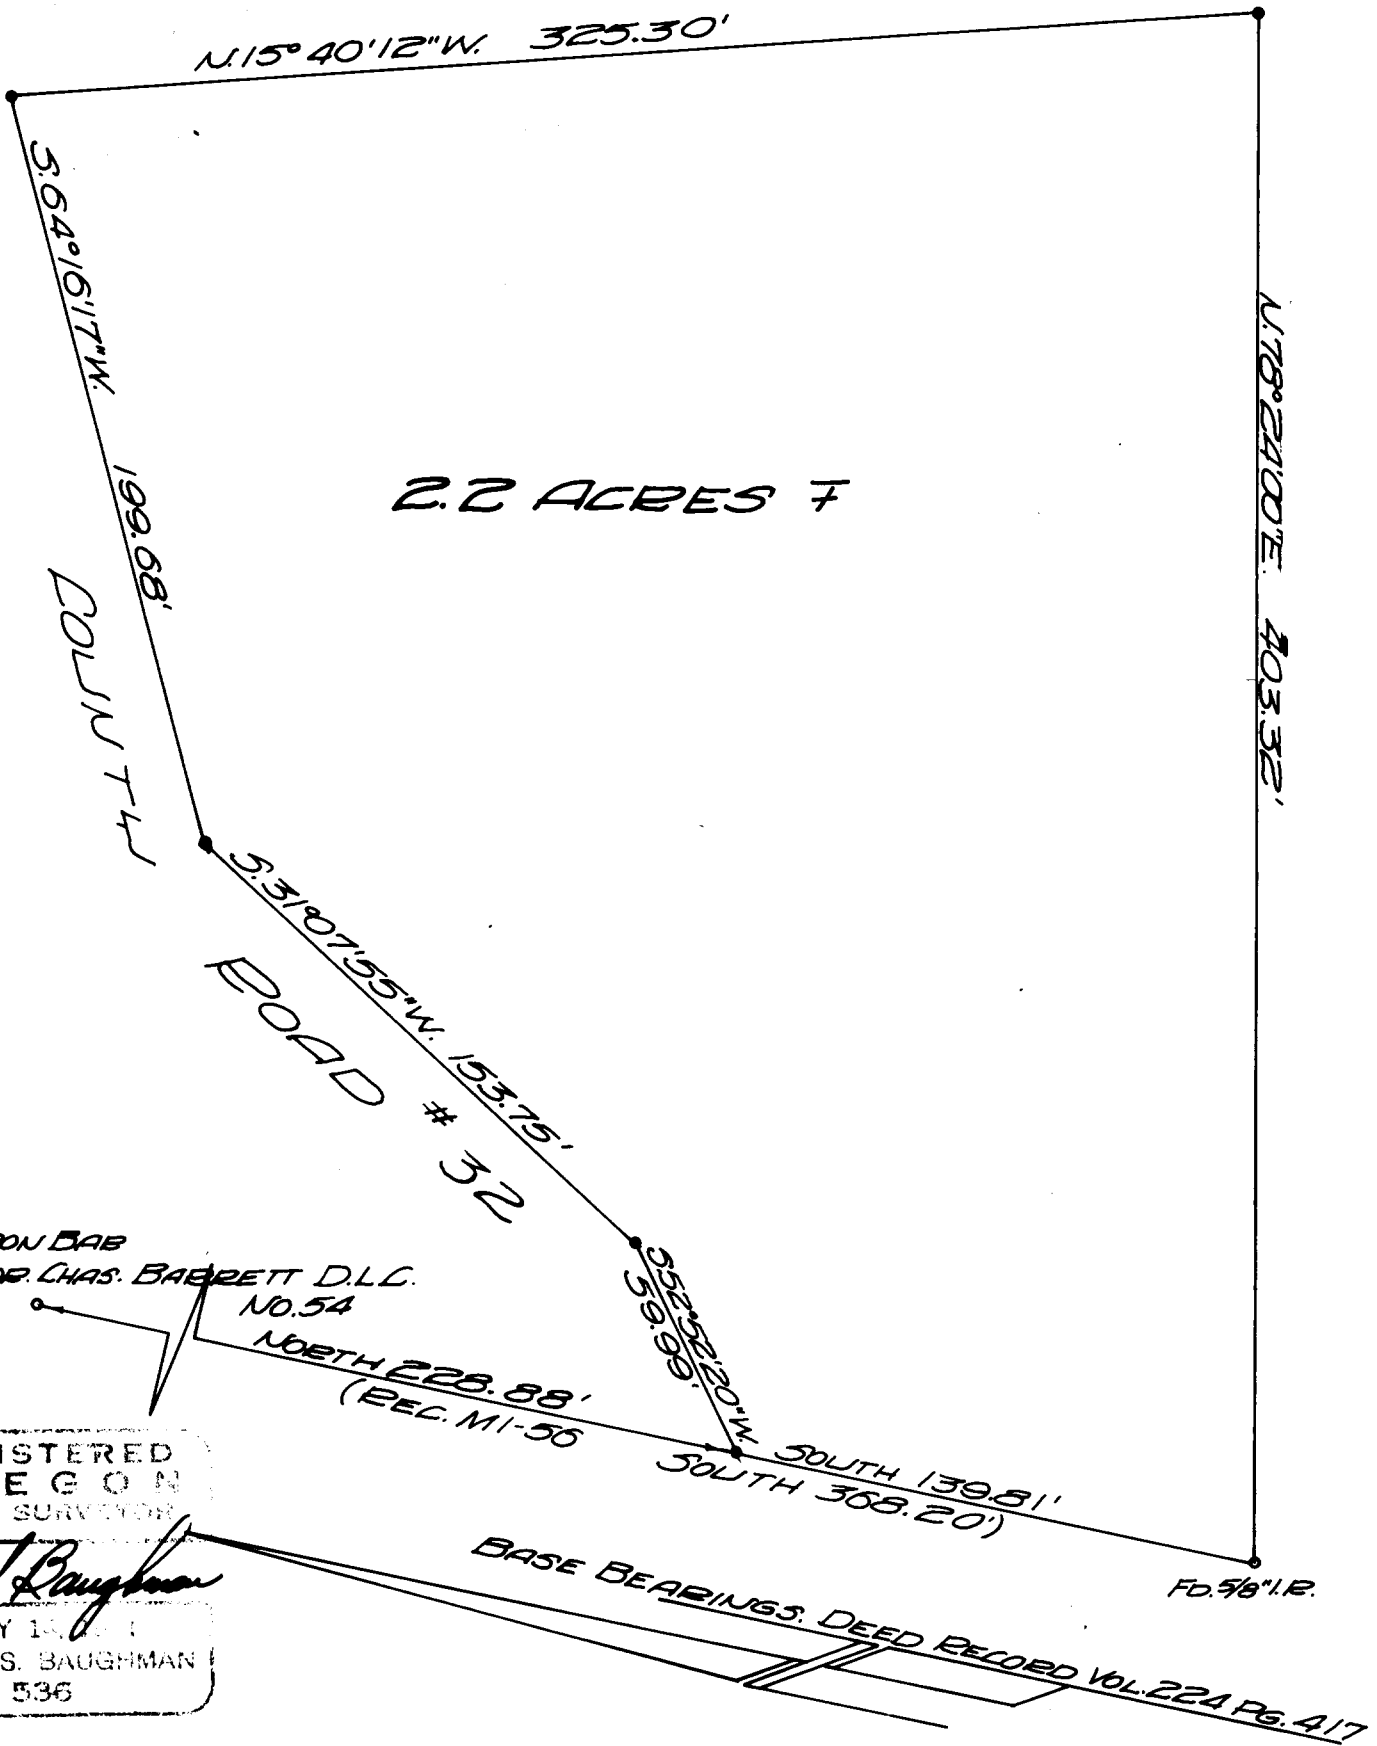

LEGEND:
• SET 5/8" IRON ROD
• AS SHOWN