


FILED
RECEIVED

DEC 21 1968

COUNTY SURVEYOR
CLATSOP COUNTY, ORE

Township No. 20 South Range No. 8 West, Will. Mer.

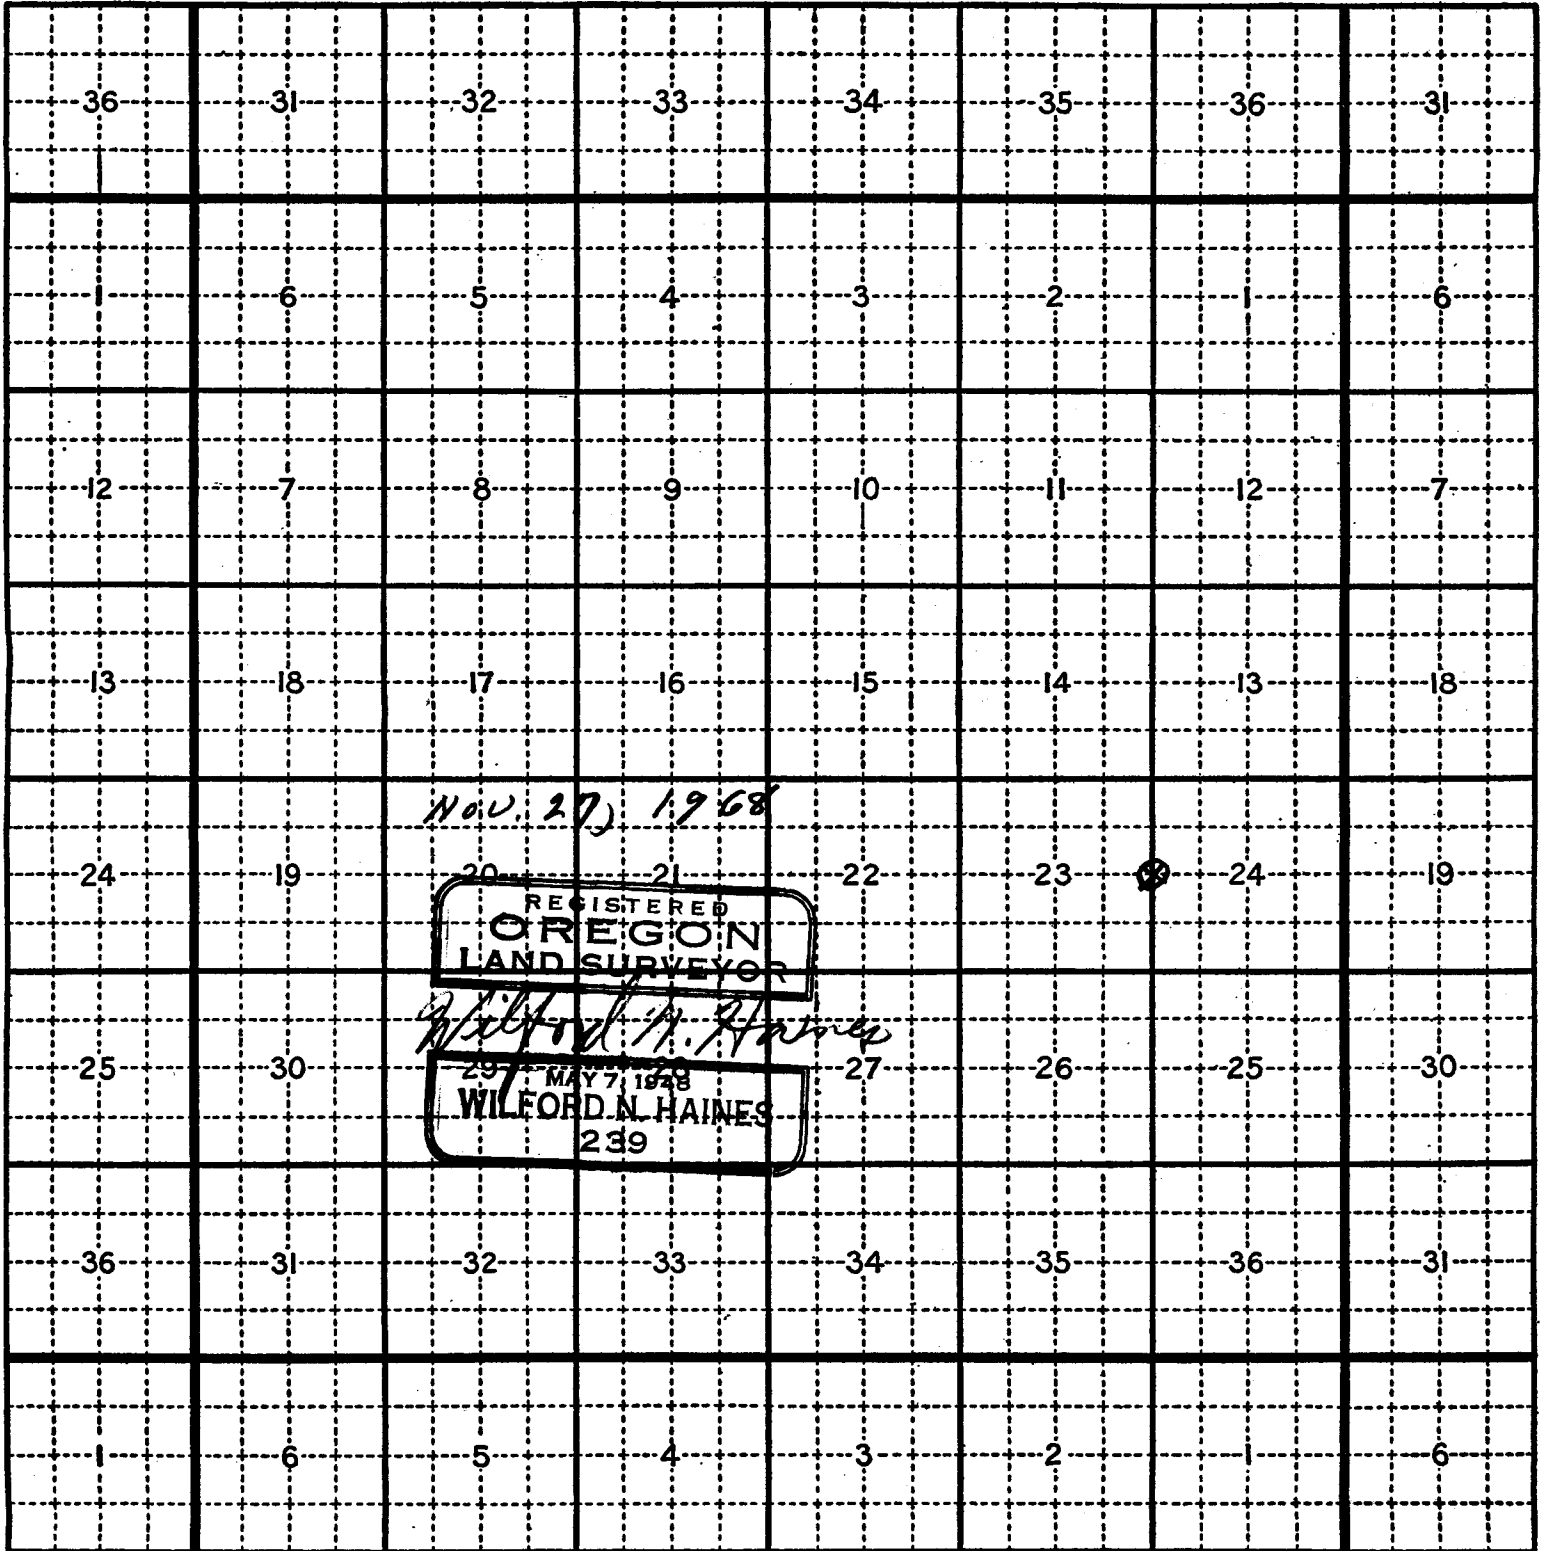

Showing adjoining sections

Scale 80 chains to an inch
0 20 40 60 80

At point for $\frac{1}{4}$ corner Sects 23+24 found area covered with 6' Murox base with waste material from Road construction. Fd. old B.t.s. Now stumps; Both showing scars for old blazes

45" fir N. 23° 15' W. ¹⁰⁶ 83-1Ks.

65" fir N. 21° 15' E. ⁸³ 1Ks. This stump has New scribe

Set iron pipe with Brass cap

Marked

T. 20 S. R. 8 W.

$\frac{1}{4}$ S 23/24

RS# 239

probably made by B.L.M.

Engineers after the

ox bow fire

(No live trees in sight)

for Crankson Logging Co