


COUNTY SURVEYORS FILE DATA  
DO NOT REMOVE FROM OFFICE

# SURVEY FOR DEED DESCRIPTION IN SEC. 17, T27 S, R6 W, W. M.

SURVEYED FOR - WALT MASK  
SURVEYED BY - R. T. REECE

JAN 1969  
SCALE 1"=100'

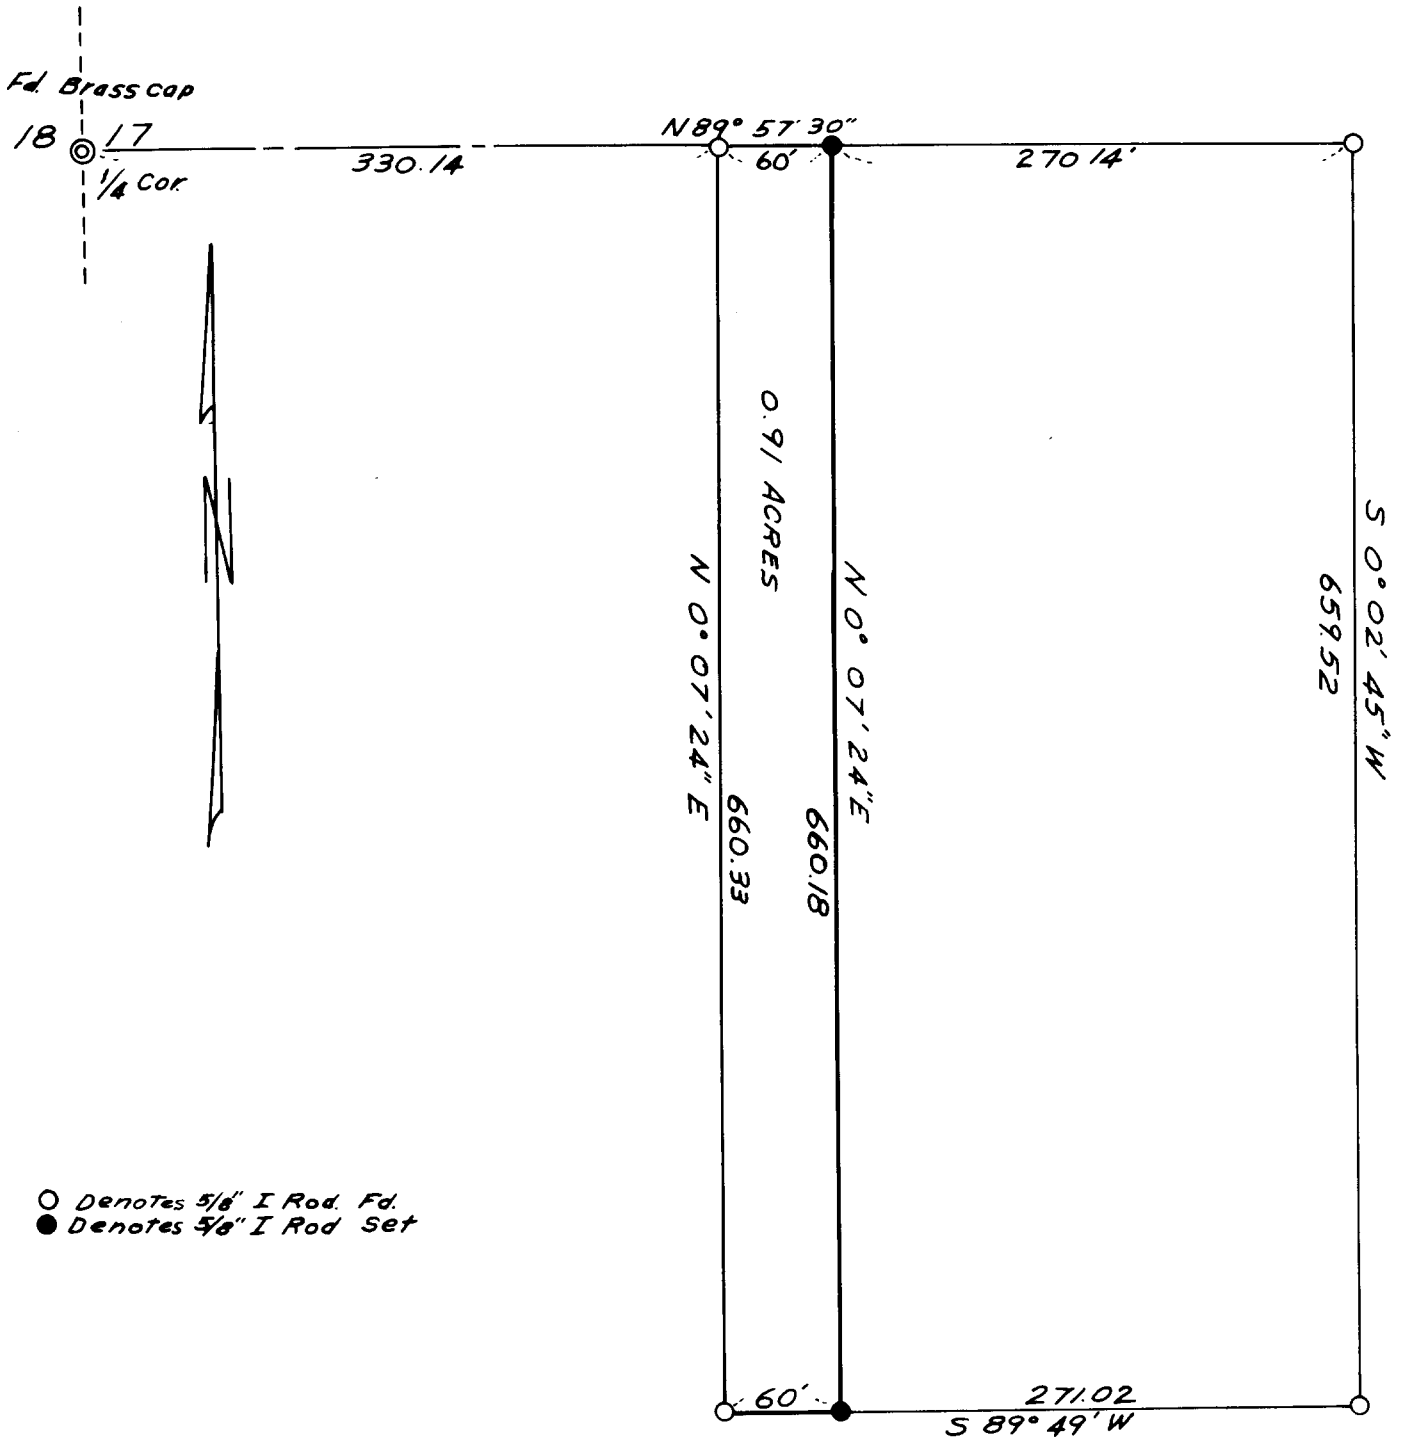

○ Denotes 5/8" I Rod. Fd.  
● Denotes 5/8" I Rod. Set

REGISTERED  
OREGON  
LAND SURVEYOR

JULY 12, 1968  
ROGER T. REECE  
864

*[Handwritten Signature]*  
COUNTY CLERK  
CLATSOP COUNTY, OREGON