

REWITNESSED CORNER FOR STATE OF OREGON--DEPARTMENT OF FORESTRY

One-quarter corner common to Sections 17 and 18, Township 22 South, Range 10 West, Willamette Meridian, Douglas County, Oregon

ORIGINAL

12' x 30' bluff (1/4 + S visible at corner point) from which a:

- 4" Fir bears S 18 E 60 lks.; now 25" stump, face closed.
- 4" Fir bears S 48 W 20 lks.; missing, slide rock.

REWITNESSED


Set 4" x 4" x 72" white painted Cedar post 2.0 ft. S 30 E of corner point, from which a:

- 18" Fir bears S 58 W 28.5 ft.; scribed 1/4 S18 BT RS 359.
- 9" Fir on spur top, course S 12 W, bears N 82 E 93.1 ft.; scribed 1/4 S17 BT.

Oregon State Forestry Department metal location poster on 18" Fir S 58 W 28.50.

Dated November 13, 1968.

Restored by E. D. Kucera under my direction.
E. D. Kucera, Transitman

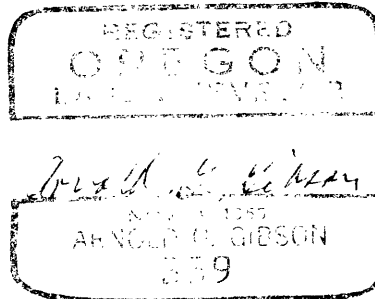

Present and witnessed by D. Smith
D. Brown
K. Eberwein