

RESTORED CORNER FOR STATE OF OREGON—DEPARTMENT OF FORESTRY

Section corner common to Sections 17, 18, 19 and 20,  
Township 22 South, Range 10 West, Willamette Meri-  
dian, Douglas County, Oregon.

ORIGINAL

Sandstone 20 x 18 x 8" (now missing, falls in clear cut area) from  
which a:

- 4" Fir bears N 88 E 50 lks.; now 30", face closed, on E-W ridge top.
- 6" Cedar bears S 69 E 40 lks.; missing, in 1964, prior to logging,  
Jerry Phillip's found windfall stub with scribes S/S (see  
affidavit).
- 4" Cherry bears S 87 W 30 lks.; missing.
- 4" Fir bears N 1 W 50 lks.; missing.
- Spur ridge, course E, bears North 20 lks.; in place.

RESTORED

Set  $1\frac{1}{2}$ " x 36" galvanized iron pipe with 3" bronze cap marked "OREGON STATE  
BOARD OF FORESTRY T22S RLOW S17 S18 S19 S20 1968 RS 359", 34 inches  
in ground, 2' South of rock bluff 12' high course E-W, and from  
which a:


- 30" Fir (original) bears N 88 E 33.0 ft.; scribed RS 359.
- 7" Fir (on ridgetop, course East, and 1' East of above bluff now  
running N-S) bears N 41 E 12.7 feet.; scribed T22S RLOW S17 BT.
- 14" Fir stump bears S 61 W 28.6 ft.; scribed T22S RLOW S19 BT.
- 30" Fir stump bears S 9 E 47.6 ft.; scribed T22S RLOW S20 BT.
- 7" XBO in above bluff bears N 23 W 2.0 ft.

Set 4 x 4 x 72" white painted Cedar post 5 ft. S 42 W of corner pipe.  
Oregon State Forestry Department metal location poster on 30" stump  
S 9 E 47.6 ft.

Also BIM poster on 30" fir (original) N 88 E 33.0 ft.

Dated December 4, 1968.

Restored by E. D. Kucera under my direction.  
E. D. Kucera, Transitman

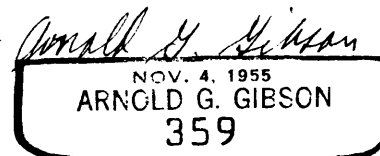

DEC 10 1968 Present and witnessed by D. Smith  
D. Brown  
K. Eberwein