

REWITNESSED CORNER FOR STATE OF OREGON--DEPARTMENT OF FORESTRY

Section corner common to Sections 34 and 35, Townships
22 and 23 South, Range 10 West, Willamette Meridian,
Douglas County, Oregon.

ORIGINAL

Stone 5' x 4' x 3' (found with 4" X, 8" from the North end and 4 notches
on the West) from which a:

- 28" Fir bears N 80 E 12 lks.; now 28" burned windfall, scribes T S R O B
visible.
- 36" Fir bears S 6 W 15 lks.; now a 52" Windfall.
- 30" Fir bears N82W 10 lks.; now a 36" windfall.
- Stone 3' high bears N 20 W 30 lks.; now a 30' high bluff in place.
- Spur, course N 15 E, bears West 60 lks.; now in place.

REWITNESSED


Marked 2 notches on the East of original stone 5' x 4' x 3', from which a:

- 50" Fir bears N 6 E 116.0 ft.; scribed T22S R10W S35 BT RS 359.
- 30' Bluff bears N 31 W 15.0 ft.; marked XBO.

Set 4" x 4" x 72" white painted Cedar post 2 ft. NW of Cornerstone.
Oregon State Forestry Department metal location poster on 50" Fir N 6 E 116.0 ft.

Dated December 16, 1968.

Restored by E. David Kucera under my direction.
E. David Kucera, Transitman

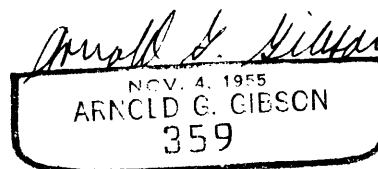

Present and witnessed by D. Smith
R. Ball