

RESTORED CORNER FOR STATE OF OREGON--DEPARTMENT OF FORESTRY

Northwest corner for Section 16, Township 22 South,  
Range 11 West, Willamette Meridian, Douglas County,  
Oregon.

ORIGINAL

Stone 10" x 8" x 7" (now missing, logged area) from which a:

- 30" Fir bears S 21 E 25 lks.; now missing.
- 16" Fir bears S 52 W 6 lks.; now a 16" x 10' stub that was growing from a root on the North side of a 50" Fir stump, bearing S 30 W 6.5 ft.; exposed scribes 2S.
- 20" Fir bears N 54 W 11 lks.; now missing.

RESTORATION by Warren D. Hootman, 1958. - PEN.#15

Found 4" x 4" white post (missing) 4 ft. N, and all original BTs.  
Mkd. 60" D. Fir N 8 $\frac{1}{2}$  W 34.0 ft.; now missing, edge of slideout.

RESTORED


Set 1 $\frac{1}{2}$ " x 36" galvanized iron pipe with 3" bronze cap marked "OREGON STATE BOARD OF FORESTRY S9 S8 T22S R11W S16 1968 RS 359", 34 inches in ground, and from which a:

- 48" Fir stump bears N 12 W 35.6 ft.; scribed T22S R11W S9 BT.
- 44" Fir stump bears S 69 W 15.7 ft.; scribed T22S R11W S8 BT.
- No trees available for BTS in Section 16.

Set 4 x 4 x 72" white painted Cedar post 1.0 ft. SE of corner pipe.  
Oregon State Forestry Department metal location poster on 48" Fir stump BT N 12 W 35.6 ft.  
Also BLM poster on the original 16" Fir S 52 W 6 lks.

Dated December 3, 1968.

Restored by E. David Kucera under my direction.  
E. David Kucera, Transitman

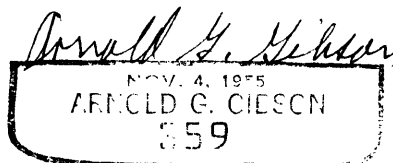

Present and witnessed by G. Gresham  
R. Ball