

RESTORED CORNER FOR STATE OF OREGON--DEPARTMENT OF FORESTRY

Closing corner common to Sections 8 and 17 (East end),
Township 22 South, Range 11 West, Willamette Meridian,
Douglas County, Oregon.

ORIGINAL

Stone 18 x 16 12" (now missing, logged area) from which a:

- 40" Fir bears S 17 W 41 lks.; now a 51" stump, face closed.
- 30" Fir bears N 26 W 41 lks.; now a 53" stump, face closed.
- 36" Fir bears S 35 E 66 lks.; now a 42" stump, exposed scribe 8.

RESTORED



Set 1 1/2" x 36" galvanized iron pipe with 3" bronze cap marked "OREGON
STATE BOARD OF FORESTRY T22S CC S8 S17 R11W S16 1968 RS359",
34 inches in ground and from which a:

- 13" Maple bears S 39 W 12.7 ft.; scribed T22S R11W S17 BT.
- 53" Fir stump (original) bears N 26 W 27.1 ft.; scribed BT RS359.
- 4 x 5 x 1 1/2' high rock outcrop bears N 41 E 4.0 ft.; marked with a
4" XBO.

Set 4 x 4 x 72" white painted Cedar post 1.0 ft. South of corner pipe.
Oregon State Forestry Department metal location poster on 13" Maple BT
S 39 W 12.7 ft. Also BLM posters on the three original BT's.

Dated December 3, 1968.

Restored by E. David Kucera under my direction
E. David Kucera, Transitman

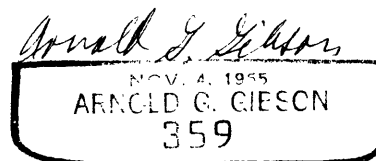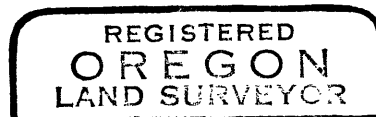

Present and witnessed by G. Gresham
R. Ball