

REWITNESSED CORNER FOR STATE OF OREGON—DEPARTMENT OF FORESTRY

One quarter corner for Section 16(West Side), Township
22 South, Range 11 West, Willamette Meridian, Douglas
County, Oregon.

ORIGINAL

24 x 16 x 16" Sandstone (in place, good condition, X and 1/4 on West
face) from which a:

36" Fir bears S 80 E 135 lks.; now 60" stump in place, used for
guyline stump, notched and spikes remain, no face visible.
4" Alder bears S 49 W 89 lks.; now missing.

REWITNESSED


Set 4 x 4 x 72" white painted Cedar post 1.0 ft. SW of corner stone,
from which a:

23" Fir bears S 12 E 16.8 ft. to face; scribed 1/4 S16 BT.
17" Fir bears S 59 E 9.4 ft. to face; scribed 1/4 S16 BT RS359.

Oregon State Forestry Department metal location poster on 17" Fir BT
S 59 E 9.4 ft.

Dated November 6, 1968.

Restored by E. D. Kucera under my direction.
E. D. Kucera, Transitman

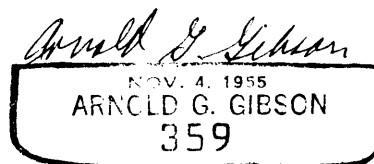

Present and witnessed by D. Smith
G. Gresham
D. Brown

DEC 18

#82

C. S. File No. 55101-9