

RESTORED CORNER FOR STATE OF OREGON--DEPARTMENT OF FORESTRY

One quarter corner for Section 25 (West Side), T22S, R12W, W.M., Douglas County, Oregon.

ORIGINAL

12" x 12" x 3' Cedar Post (missing) from which a:
15" Alder bears N74E 39 lks.; missing.
24" Maple bears S52E 40 lks.; now 32" windfall, exposed scribe 5.
Ridge, Course SE & NW, bears North 89 lks.; in place.


RESTORED

Set 1½" x 36" galvanized iron pipe with 3" bronze cap marked "OREGON STATE BOARD OF FORESTRY 1/4 S25 1969 RS359", 34 inches in ground, and from which a:
17" Cedar bears S60°E 15.0 ft. to face; scribed 1/4 S25 BT RS359.
24" Cedar bears S41°E 44.6 ft. to face; scribed 1/4 S25 BT.

Set 4" x 4" x 72" white ainted Cedar post 2.0 ft. NW of corner pipe. Oregon State Forestry Department metal location poster on 17" Cedar S60E 15.0'.

Dated July 16, 1969.

Restored by Lloyd D. Smith under my direction.
Lloyd D. Smith, Transitman

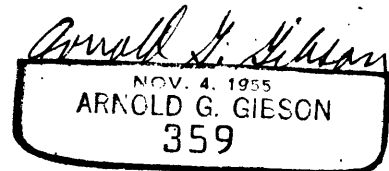

Present and witnessed by David H. Stere.

FILED
RECEIVED

SEP 9 1969

COUNTY SURVEYOR
DOUGLAS COUNTY, ORE.

#61