

RESTORED CORNER FOR STATE OF OREGON--DEPARTMENT OF FORESTRY

Section corner common to Sections 26 and 35, (East end),  
Township 22 South, Range 12 West, Willamette Meridian,  
Douglas County, Oregon.

ORIGINAL

12" x 12" x 3' Fir Post (found original point with axe work), from  
which a:

32" Fir bears S 57 W 17 lks.; now 44", face closed.  
28" Fir bears N 67 W 33 lks.; now 34", face partially rotted,  
exposed scribe 2.

RESTORED

Set 1½" x 36" galvanized iron pipe with 3" bronze cap marked "OREGON  
STATE BOARD OF FORESTRY T22S R12W S26 S35 S25 1968 RS 359", 34  
inches in ground, in original post hole, in mound of rock, and  
from which a:


44" Fir (original) bears S57 W 11.2 ft.; scribed BT.  
34" Fir (original) bears N 67 W 21.8 ft.; scribed RS 359.

Set 4" x 4" x 72" white painted Cedar post 1.0 ft. South of corner pipe.  
Oregon State Forestry Department metal location poster on 34" Fir BT  
N 67 W.

Also BIM poster on 44" Fir BT S 57 W.

Dated January 1, 1969.

Restored by Lloyd D. Smith under my direction.  
Lloyd D. Smith, Transitman

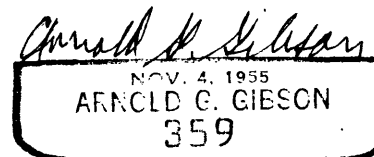

±54

○ Present and witnessed by George Gresham

FILED  
RECEIVED

MAY 20 1969

COUNTY SURVEYOR  
DOUGLAS COUNTY, ORE.