

RESTORED CORNER FOR STATE OF OREGON--DEPARTMENT OF FORESTRY

One quarter corner common to Sections 34 and 35, Township 22 South, Range 12 West, Willamette Meridian, Douglas County, Oregon.

ORIGINAL

Cedar post (missing) from which a:

- 42" Cedar bears N 27 W 90 lks.; missing, roots in place.
- 36" Fir bears S 17 E 153 lks.; missing, open pasture.
- Foot of ridge bears North 1.00 chain; in place.
- Branch, 5 links wide, course S 70 W, bears North 35 links; in place.
- Leave bottom bears South 5.00 chains; in place.
- A trail, SW-NE, bears South 6.10 chains; in place.
- A trail, SE-NW, bears South 11.20 chains; in place.
- Mrs. Fox's house bears East 10.00 chains; missing, fence or gate post found, no testimonial evidence available.

RESTORED

Set 1½" x 36" galvanized iron pipe with 3" bronze cap marked "OREGON STATE BOARD OF FORESTRY 1/4 S34 S35 1969 RS359", 55 inches in ground, in pasture, and from which a:

- 35" Myrtle bears N 22 E 83.4 ft. to face; scribed 1/4 S35 BT RS359.
- 8" Fir bears N 49½ W 86.1 ft. to face; scribed 1/4 S34 BT.

Set 4" x 4" x 72" white painted Cedar post 68.6 ft. S 4½ W of corner pipe on fence line (bears N 40 W).
Oregon State Forestry Department metal location poster on the 35" Myrtle BT N 22 E.

Dated March 16, 1969.


Restored by Lloyd D. Smith under my direction.
Lloyd D. Smith, Transitman

FILED
RECEIVED

MAY 20 1969

COUNTY SURVEYOR
DOUGLAS COUNTY, ORE.

57

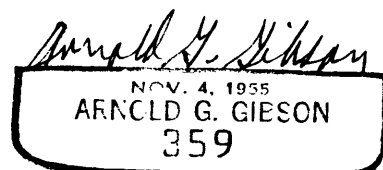

Present and witnessed by George Gresham
David Brown