

Section 2, Township 30 South, Range 1 West, W.M.

Center $\frac{1}{4}$ Section Corner

Set: 2 $\frac{1}{2}$ " Alum Cap.
10" Douglas Fir, S. 10° W., 12.7 ft.; Mkd. C $\frac{1}{4}$ -S2-BT
14" Douglas Fir, N. 63° E., 11.5 ft.; Mkd. C $\frac{1}{4}$ -S2-BT


#112

Section 35, Township 29 South, Range 1 West, W.M.

South $\frac{1}{4}$ Corner

Found: 2 $\frac{1}{2}$ " Alum Cap.
4" Douglas Fir, S. 24° W., 16.0 ft. (Dead)
9" Douglas Fir, N. 16° W., 14.5 ft. (Down)
Set: 8" Douglas Fir, N. 32 E., 19.9 ft.; Mkd. S. $\frac{1}{4}$ -S35-BT

#17 729-1w

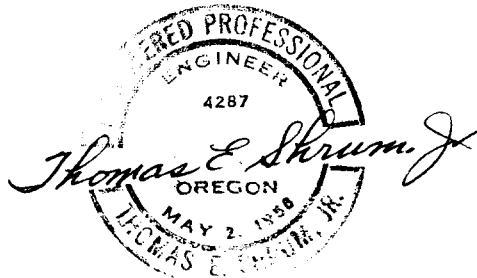

NOV 28 1957

CLERK COUNTY ENGINEER

SEE M36-14

C.S. File No. 55/106 A

Section Corner 9, 10, 15, 16, Township 25 South, Range 1 West, W.M.

Found: 7" Cedar, S. $74^{\circ}E$, 49.5 ft.; Mkd. S 15 CS BT
8" Hemlock, N. $58\frac{1}{2}^{\circ}E$, 28.3 ft. (Down)

Set: $1\frac{1}{2}$ " Iron Pipe (Reset original pipe)
30" Fir Stump, S. $71\frac{1}{2}^{\circ}W$, 21.3 ft.; Mkd. S 16 BT
20" Fir Stump, N. $06^{\circ}W$, 36.7 ft.; Mkd. S 9 BT
10" Yew, N. $56\frac{1}{2}^{\circ}E$, 95.6 ft.; Mkd. S 10 BT


Ren. # 91

$\frac{1}{4}$ Section Corner, Section 10 and 15, Township 25 South, Range 1 West, W.M.

Found: $\frac{3}{4}$ " Iron Rod
8" Hemlock Stump, N. $26\frac{1}{2}^{\circ}E$, 33.3 ft.; Mkd. $\frac{1}{4}$ S 10 CS BT
16" Hemlock Stump, S. $47\frac{1}{2}^{\circ}E$, 19.9 ft.; Mkd. $\frac{1}{4}$ S 15

#43

L. STEEL FENCE POST SET
ADD TO REN.

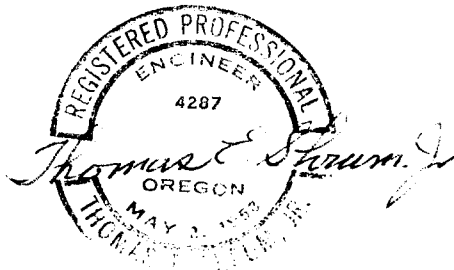

NOV 26 1958

COUNTY SHERIFF
DEPT. OF CORRECTIONS

C. S. File No. 55/106 b

U.S. Plywood



P. O. Box 1328 • Roseburg, Oregon 97470 • Phone 672-3331

November 22, 1968

Mr. James Byron
Douglas County Surveyor
Courthouse
Roseburg, Oregon

Dear Mr. Byron

Please find enclosed information for corners in:

Section 10, T. 25 S., R. 1 W., W.M.
Section 2 T. 30 S., R. 1 W., W.M.
Section 35 T. 29 S., R. 1 W., W.M.

Yours very truly,

Tom E. Shrum, Engineer
ROSEBURG OPERATIONS

TES:cs
Encl.'s

NOV 26 1968
COUNTY CLERK
DOUGLAS COUNTY, OREGON