


CERTIFIED RECORD OF LAND CORNER MONUMENTATION

History of original corner establishment:

None

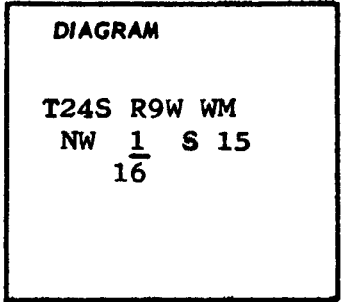

Description of corner evidence found:

None

REGISTERED  
OREGON  
LAND SURVEYOR

*Glenn S. Baughman*

JULY 14, 1961  
GLENN S. BAUGHMAN  
536

Description of monument and accessories I established to perpetuate the original location of this corner

I set a 2" by 30" galvanized iron pipe, with brass cap, 26" in the ground.

I stamped the cap

T24S R9W WM  
NW  $\frac{1}{16}$  S 15  
16  
1969  
OLS 536

From the iron monument I marked

A 8" Hemlock NW 1/16 S 15 BT which bears N 34 1/2° W 29.5 FT.

A 8" Douglas Fir NW 1/16 S 15 BT which bears S 15° E 36.6 FT.

I set bearing tree tags on all bearing trees facing the monument.

Office of.....SURVEYOR..... County of.....DOUGLAS.....  
State of.....OREGON....., I hereby certify that the within instrument was filed in this office  
for record on the ...4... day of ...April....., 1969, at 9:30'clock a.m., (signed)

*James A. Ryan*  
(COUNTY OFFICIAL)

by..... (DEPUTY)