


CERTIFIED RECORD OF LAND CORNER MONUMENTATION

History of original corner establishment:

None

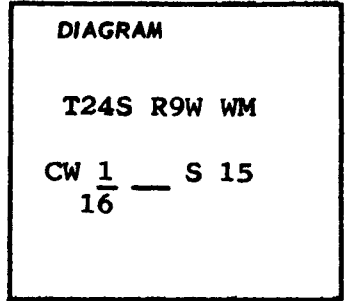

Description of corner evidence found:


None



Description of monument and accessories I established to perpetuate the original location of this corner

I set a 2" by 30" galvanized iron pipe, with brass cap, 26" in the ground.

I stamped the cap

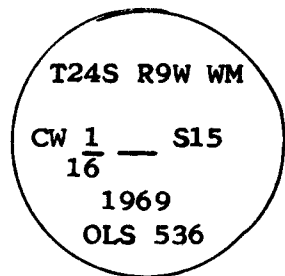

From the iron pipe monument I marked

A 13" Douglas Fir CW 1/16 S 15 BT which bears N 76 1/2° W 24.4 FT.

A 10" Hemlock CW 1/16 S 15 BT which bears S 52°W 18.0 FT.

I set bearing tree tags on all bearing trees and facing the monument.

Office of.....SURVEYOR..... County of.....DOUGLAS.....
 State of.....OREGON....., I hereby certify that the within instrument was filed in this office
 for record on the 4 day of April, 1969, at 9:30 o'clock a.m., (signed)
James W. Ryan by
 (COUNTY OFFICIAL) (DEPUTY)