


CERTIFIED RECORD OF LAND CORNER MONUMENTATION

History of original corner establishment:

None

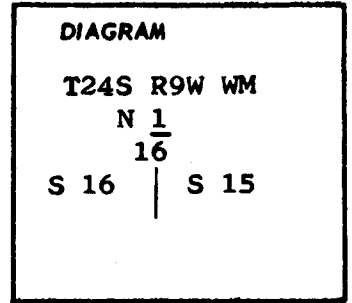

Description of corner evidence found:


None



Description of monument and accessories I established to perpetuate the original location of this corner

I set a 2" by 30" galvanized iron pipe, with brass cap, 26" in the ground.

I stamped the cap

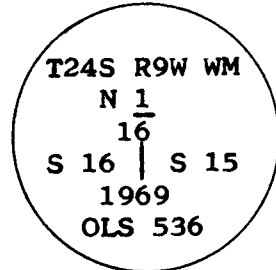

From the iron monument I marked

A 12" Hemlock N 1/16 S 15 BT which bears S 42° E 37.7 FT.

A 28" Douglas Fir N 1/16 S 16 BT which bears S 67° W 26.1 FT.

I set bearing tree tags on all bearing trees facing the monument.

Office of SURVEYOR County of DOUGLAS  
 State of OREGON, I hereby certify that the within Instrument was filed in this office  
 for record on the 4 day of April, 19 69, at 9:30 o'clock A. m., (signed)  
*James W. Ryan* by \_\_\_\_\_  
 (COUNTY OFFICIAL) (DEPUTY)