


COUNTY SURVEYORS FILE DATA
DO NOT REMOVE FROM OFFICE

FILED
RECEIVED

AUG 2 1968
COUNTY SURVEYOR
DOUGLAS COUNTY, ORE.

LEGEND

- ⊙ IRON PIPE FOUND
- ⊙ IRON ROD SET 5/8"
- PK NAIL SET
- PK NAIL FOUND
- () CALL DIST.

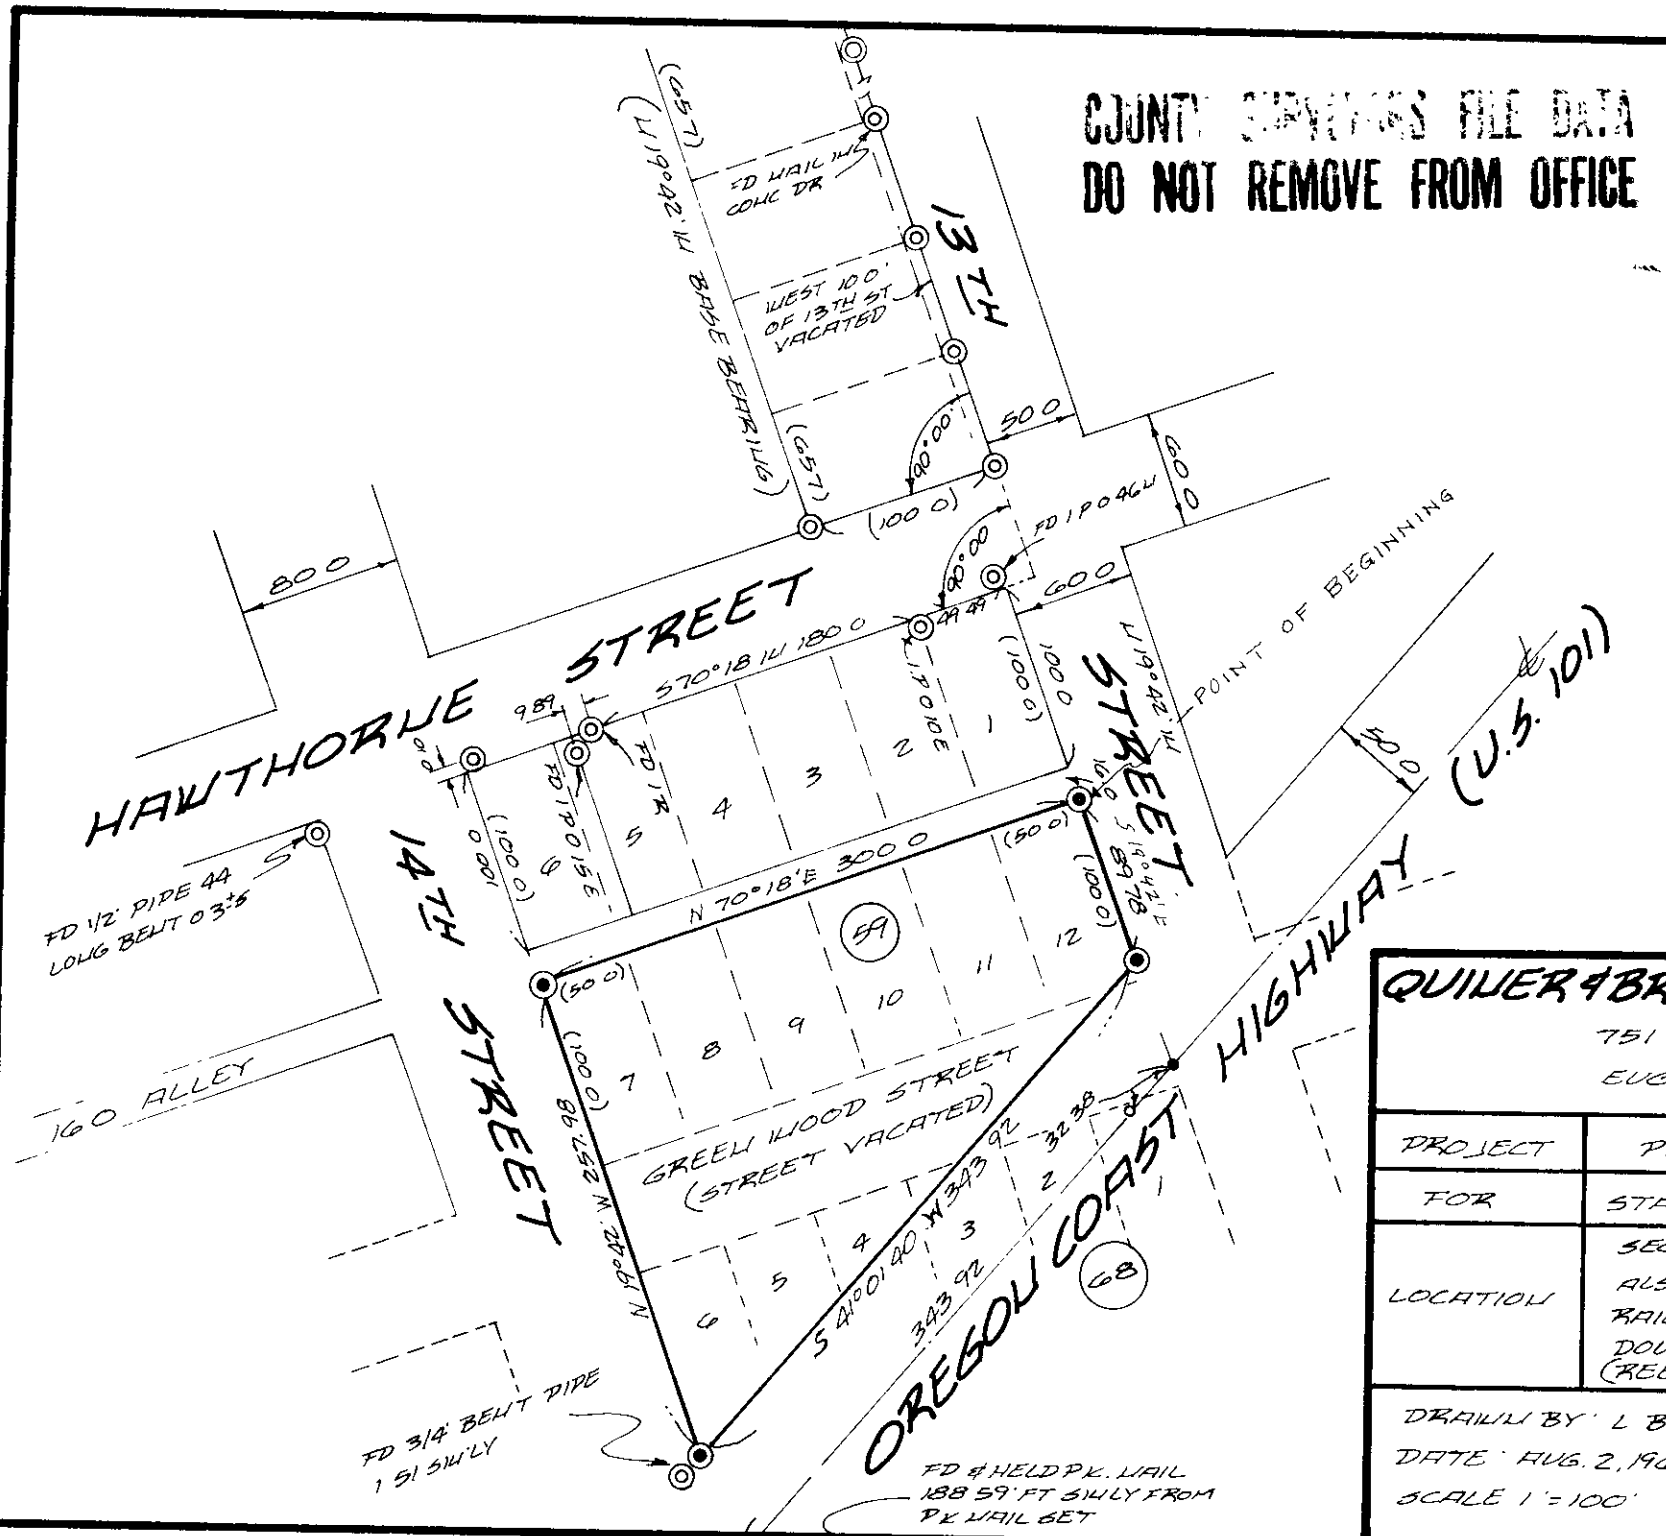

QUINER & BRITTON CONSULTING ENGINEERS
751 WEST 12TH AVENUE
EUGENE, OREGON

PROJECT	PROPERTY SURVEY
FOR	STANDARD OIL CO OF CALIF.
LOCATION	SEC. 34 TWP. 21, S RGE 12 NW 1/4, ALSO BEING A PORTION OF RAILROAD ADD BLK. 59, 14 DOUGLAS COUNTY, OREGON (REEDSPORT)
DRAWN BY: L BORUP	
DATE: AUG. 2, 1968	
SCALE 1" = 100'	

FB 28-55

