

SURVEYED TO ESTABLISH PROPERTY CORNERS
 SITUATED IN LOT No. 8, BLK. 7, DILLARD BOTTOM SUBDIVISION
 SEC. 29, TWP. 28S, RG. 6W.W.M.

SURVEYED FOR EDMOND L CASE
 BY BAUGHMAN & ACKARET INC. MAY 23, 1969


COUNTY SURVEYORS FILE DATA
 NO NO. REMOVE FROM OFFICE
 SCALE 1"=40'

- SET 5/8" IRON ROD
- FOUND 1" IRON PIPE


REGISTERED
 OREGON
 LAND SURVEYOR

Glenn S. Baughman

JULY 14, 1961
 GLENN S. BAUGHMAN
 536

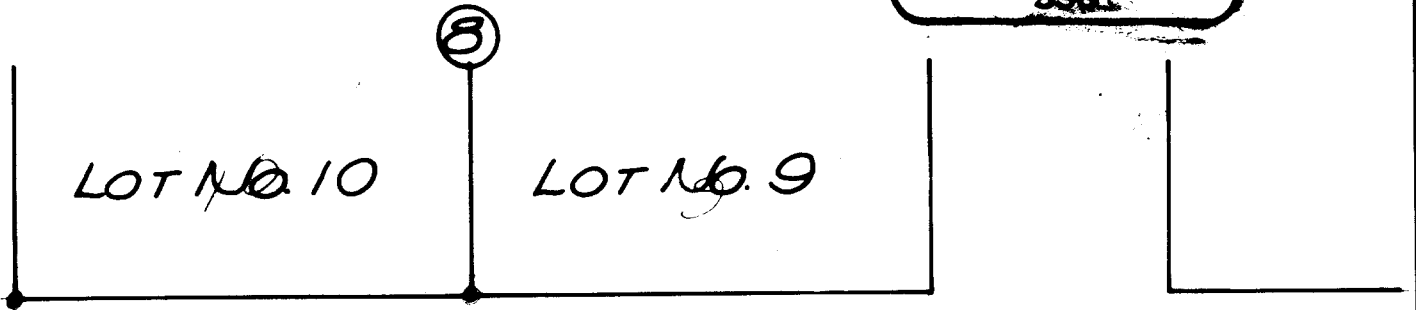

4TH STREET S.89°55'W.

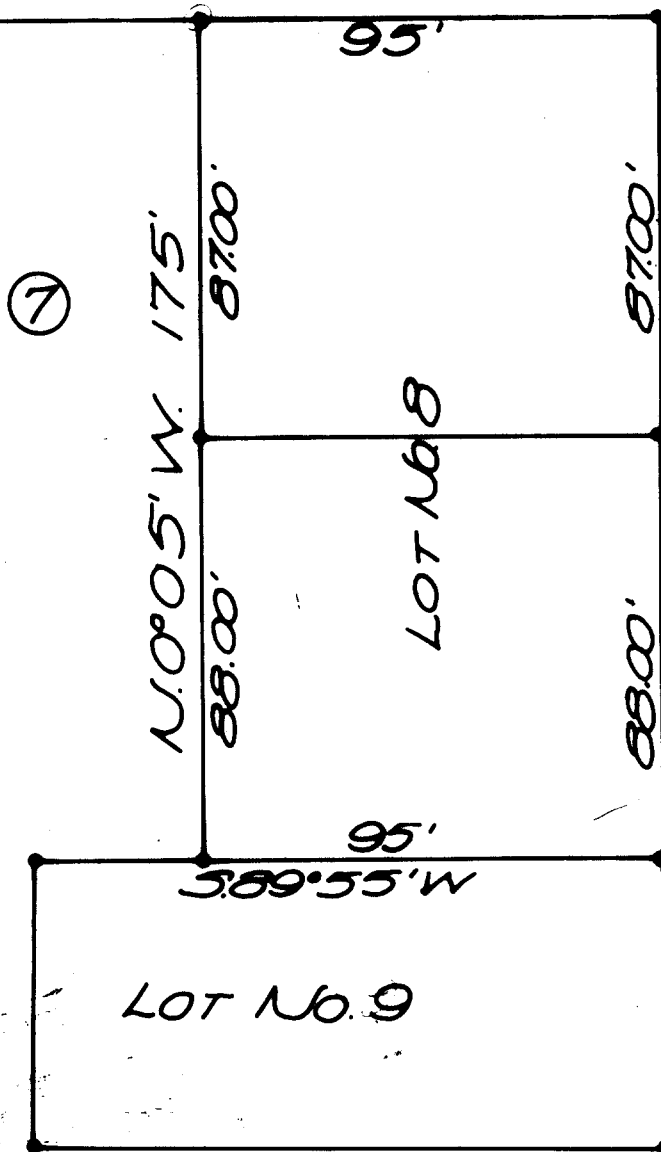

FILED
 RECEIVED

JUN 10 1969

COUNTY SURVEYOR
 WASHINGTON COUNTY, OREGON

P