

COUNTY SURVEYORS FILE DATA

SURVEY IN LOT 2, FISK FRUIT FARMS DO NOT REMOVE FROM OFFICE

SURVEYED FOR LESTER R. AND ODELIA E. JENNINGS


SURVEYED BY R. H. GEE — OCTOBER, 1970

SCALE 1" = 100'



*[Handwritten scribble]*

*[Faint handwritten notes]*

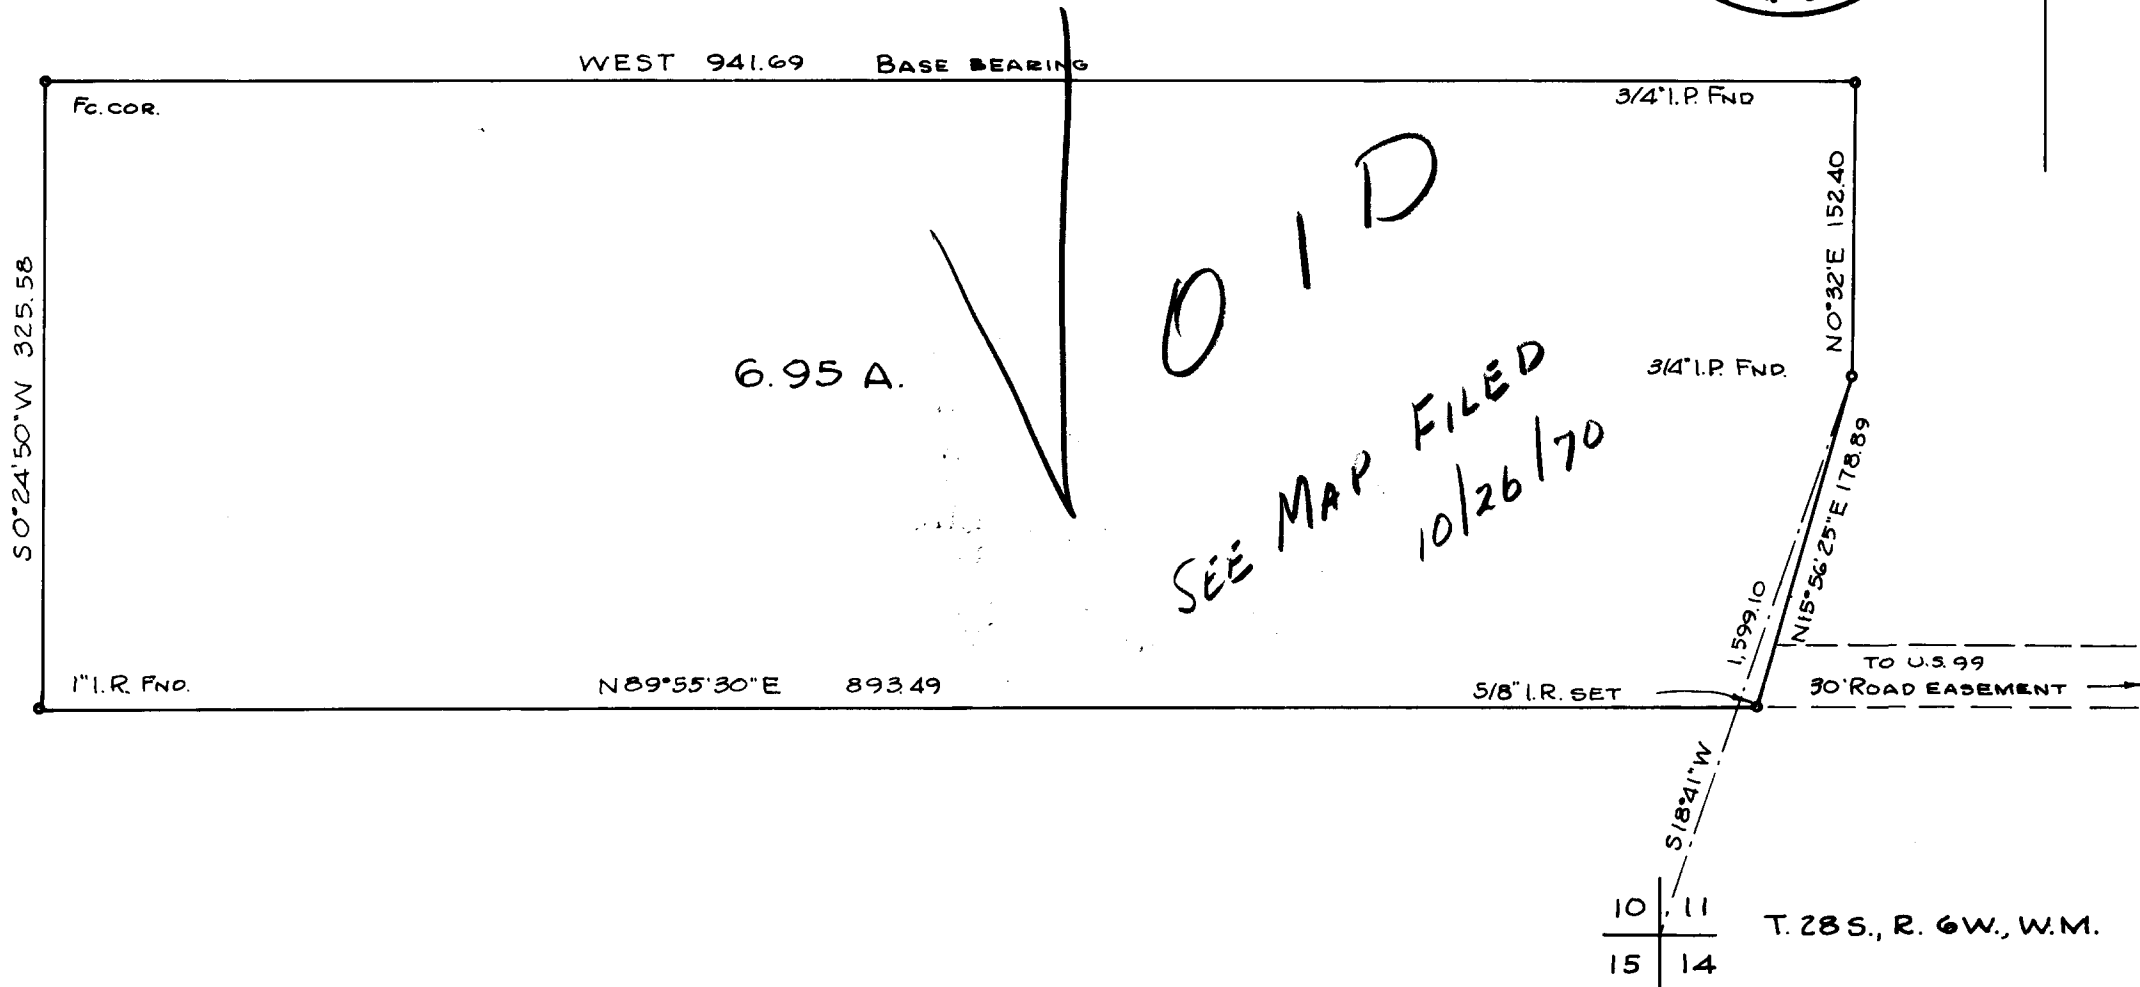

P