


**CORNER RESTORATION  
OF  
SECTION CORNER COMMON TO**

**S 29, S30, S 31, S 32      TWP 20S R11W W.M.**

SCALE 1" = 100'

OCTOBER 1969

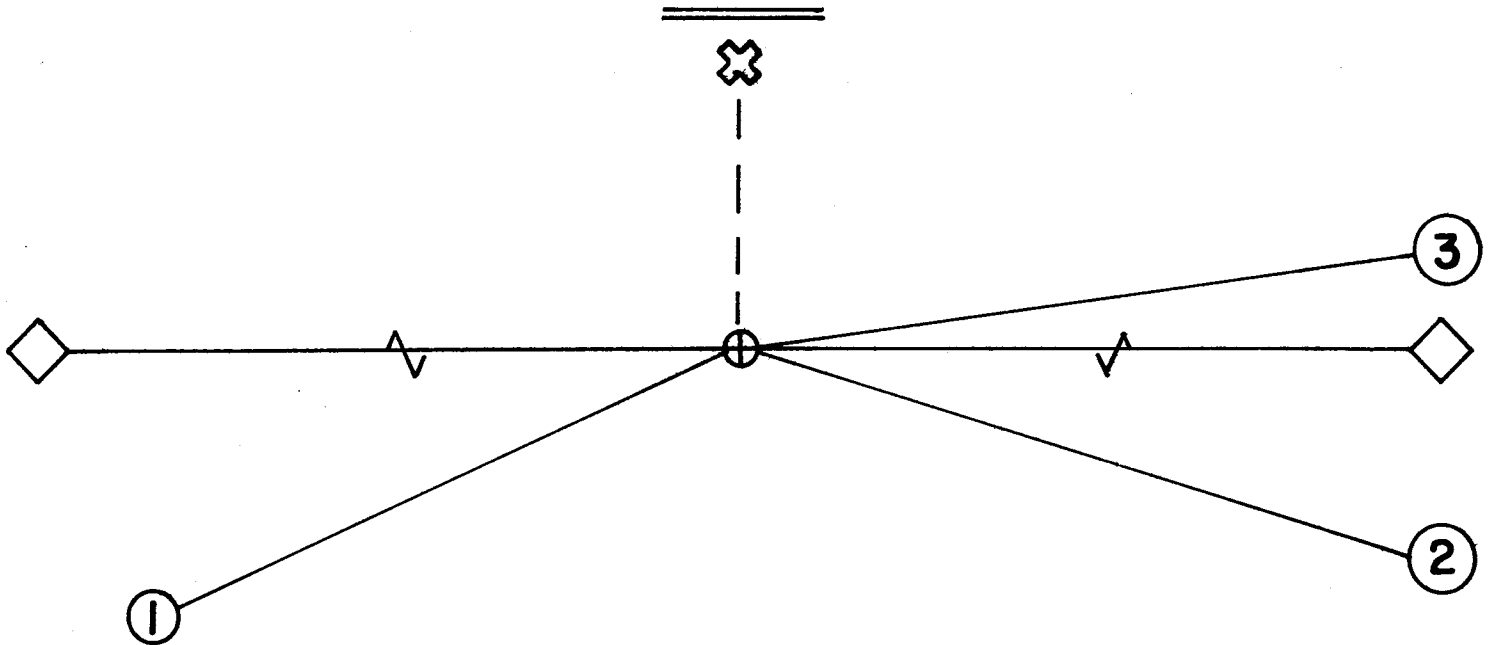

**LEGEND**

- ⊕ A BRASS-CAPPED IRON PIPE FROM WHICH:
  - ① THE ORIGINAL DOUG. FIR B.T. STUMP 46" IN DIA. BEARS S 66°W 32.2' WITH SCRIBE MARKS VISIBLE; AND
  - ② A 41" DOUG. FIR STUMP BEARS S 74°E 36.4 FEET WITH SCRIBE MARKS VISIBLE; AND
  - ③ AND A 36" DOUG. FIR STUMP BEARS N 82°E 35.1 FEET WITH SCRIBE MARKS VISIBLE; AND
  - ◇ A 72" STEEL FENCE POST DRIVEN 30" INTO THE GROUND, EACH ONE DRIVEN 40' FEET FROM AND ON AN EAST-WEST LINE THROUGH THE CORNER; AND
  - ⊕ A POST AND LOCATION POSTER BESIDE THE LEITEL CREEK TIE ROAD BEARS N 5°W 298'.

I DO HEREBY CERTIFY THAT THE ABOVE DESCRIBED CORNER WAS RESTORED BY ME IN ACCORDANCE WITH LAW AND ALL ACCESSORIES ARE AS SHOWN

FILED  
RECEIVED

OCT 6 1969

COUNTY SURVEYOR  
DOUGLAS COUNTY, ORE.

Ren. #63

REGISTERED  
**OREGON**  
LAND SURVEYOR

*Dennis A. Crowe*

JULY 12, 1968  
DENNIS A. CROWE  
845

C.S. FILE NO. 55/128