

August 19, 1969

RENEWAL OF E $\frac{1}{2}$ COR. SEC. 9 T28S R3E

I removed brass cap for road construction and referanced the spot for later replacement. —1966

Reset the brass cap and set two new bearing trees: 1969

FIR Old BTs destroyed in construction
A 14" Shasta bears N 18° W 52.5 feet
marked $\frac{1}{4}$ S 9 BT

FIR
A 28" Shasta bears S 87° E 87.5 feet
marked $\frac{1}{4}$ S 10 BT


This corner is in the road fill approximately 15 feet from road shoulder.

Witness:

Al Keatley



Burton W. Holt

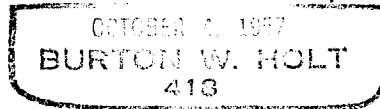

FILED
RECEIVED

AUG 28 1969

COUNTY SURVEYOR
DOUGLAS COUNTY, ORE.

#1

C. S. File No. 55/133