

# SURVEYED FOR DEED DESCRIPTION

LOCATED IN LOT 3, BLK. 5, LAWSON ACRES  
FOR LAWSON ACRES WATER ASSOC.

BY BAUGHMAN & ACKARET INC.

DATE MARCH 1970

COUNTY SURVEYORS FILE DATA  
DO NOT REMOVE FROM OFFICE

FILED *[Signature]*  
RECEIVED

MAR 18 1970


COUNTY SURVEYOR  
DOUGLAS COUNTY, ORE.



T. 30 - 5 Sec. 19

T. 30 - 6

BASE BEARINGS LAWSON ACRES

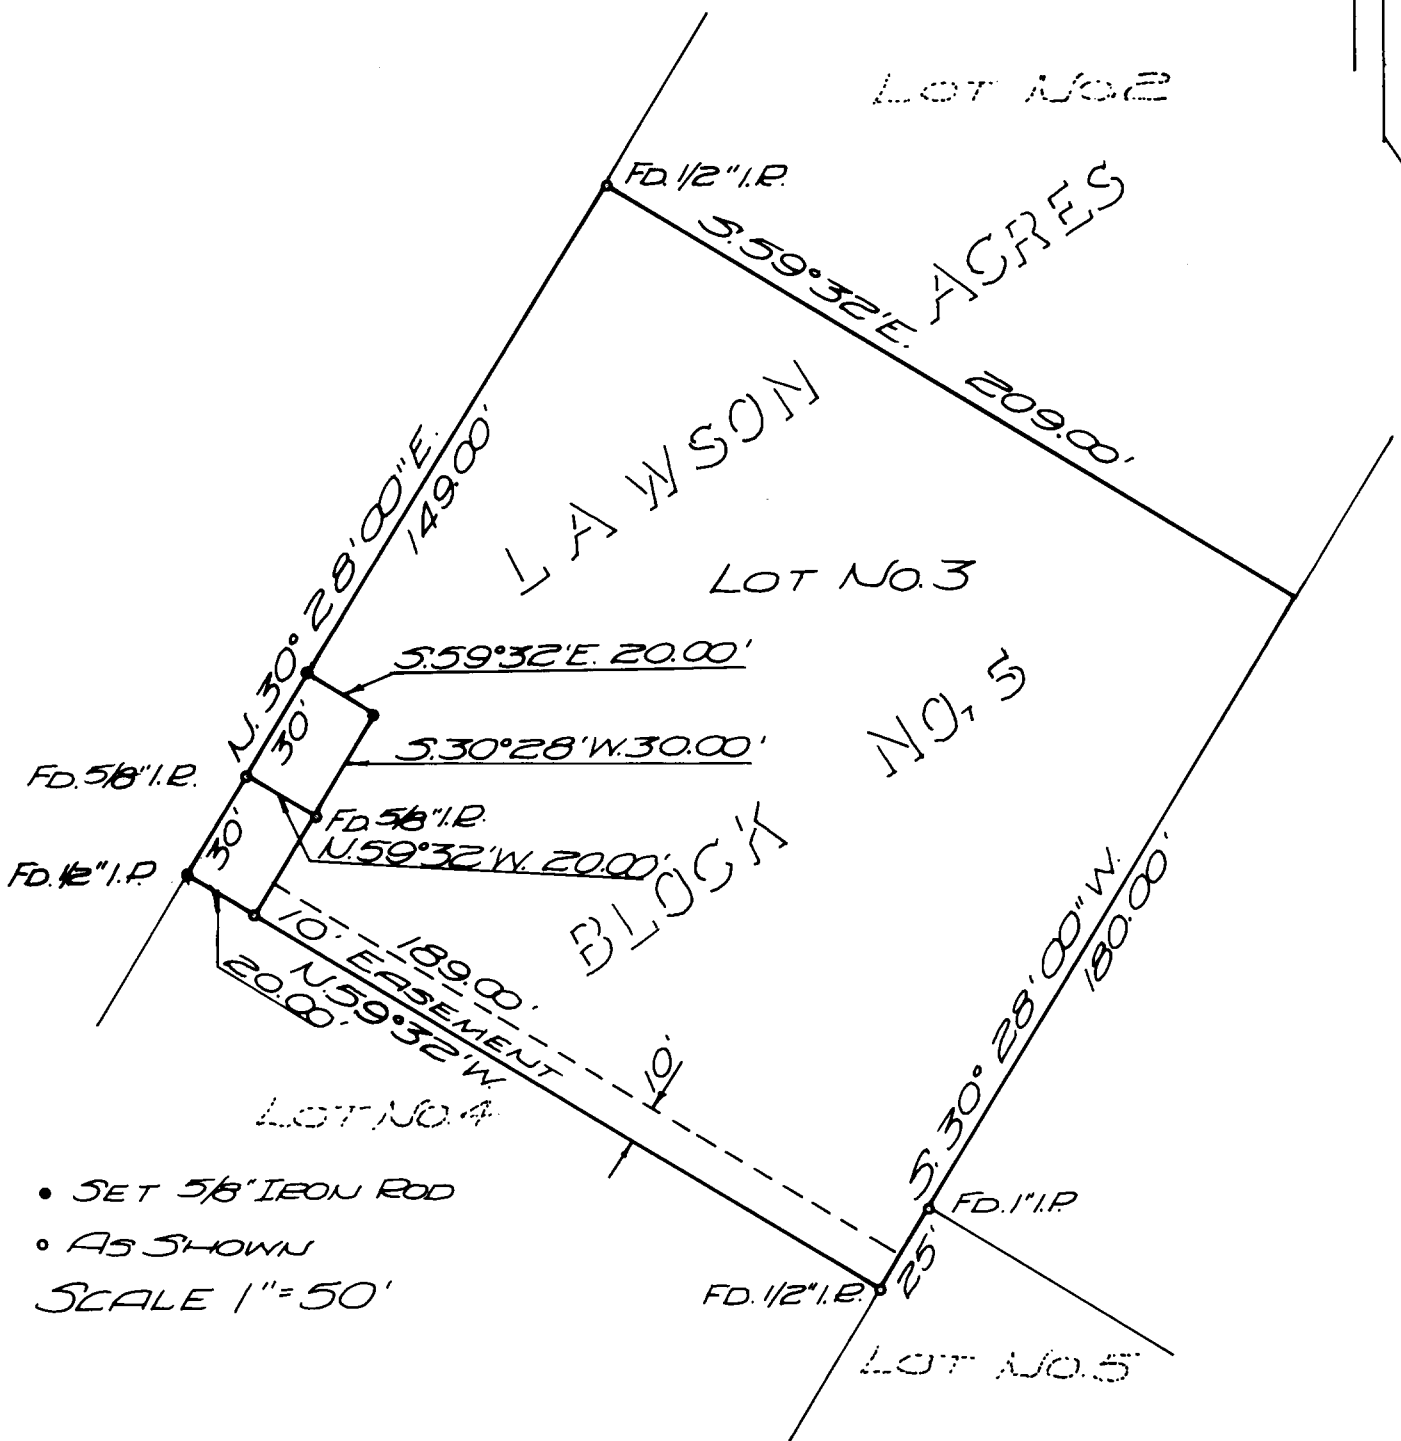

- SET  $5/8''$  IRON ROD
  - AS SHOWN
- SCALE 1" = 50'