


CERTIFIED RECORD OF LAND CORNER MONUMENTATION

History of original corner establishment:

Section corners established in 1892 by W. P. Wright

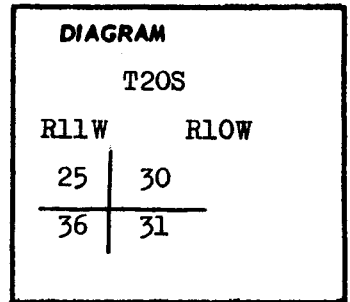

Description of corner evidence found:


Found 1½" pipe from which

24" maple stump brs. N32W 25.0 ft. (orig)
face chopped out, evidence of old chop marks and face, with tag

60" fir brs. S18W 70.3 ft.
scribed S36 CS, with tag

Description of monument and accessories established to perpetuate the original location of this corner

Set 2"x30" iron pipe with brass cap mkd

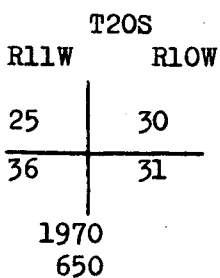

from which

4" chittenwood brs. N72E 27.6 ft.
scribed R10 S31 BT, with tag

6" cedar brs. N20W 47.3 ft.
scribed R11 S25 BT, with tag

Set 2 fence posts with signs ± 5 ft. west facing south
± 5 ft. north facing east

#38-T20-10
#77-T20-11

**REGISTERED
OREGON
LAND SURVEYOR**

Tom O. McCullough
JULY 10, 1964
TOM O. McCULLOUGH
650

Office of LAND SURVEYOR County of DOUGLAS
State of OREGON, I hereby certify that the within instrument was filed in this office
for record on the 13 day of MARCH; 1970, at 10 o'clock A.M., (signed)
James C. ... by ... (DEPUTY)

**FILED
RECEIVED**