


CERTIFIED RECORD OF LAND CORNER MONUMENTATION

History of original corner establishment:

1/4 corner established in 1892 by W. P. Wright

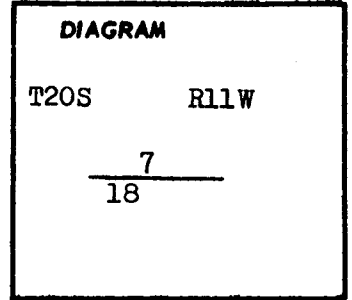

Description of corner evidence found:

No monument found, from point of true corner

48" fir stump brs. N83E 27.0 ft. (orig)
face visible from top, with tag

Description of monument and accessories established to perpetuate the original location of this corner

Set a 2"x30" iron pipe with brass cap mkd

T20S	R11W
$\frac{7}{18}$	
1970	
650	from which

10" alder brs. S68W 23.4 ft.
scribed S18 BT, with tag

Set fence post with signs + 5 ft. east facing south.

#48

REGISTERED OREGON LAND SURVEYOR

T. O. McCullough

JULY 10, 1964 TOM O. McCULLOUGH 650

Office of CO. SURVEYOR County of DOUGLAS
 State of ORE, I hereby certify that the within instrument was filed in this office
 for record on the 13 day of MARCH; 1970, at 10 o'clock A.M., (signed)
[Signature] by _____
 (COUNTY OFFICIAL) (DEPUTY)

FILED
RECEIVED

MAR 13 1970

COUNTY SURVEYOR
DOUGLAS COUNTY, ORE.