


CERTIFIED RECORD OF LAND CORNER MONUMENTATION

History of original corner establishment:

1/4 corner established in 1892 by W. P. Wright.
Reestablished by Hootman OLS 399 in 1957

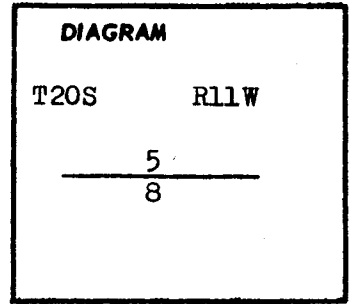

Description of corner evidence found:

Found 1" iron pipe from which
12" alder brs. N41E 3.0 ft.
scribing visible, has FS tags
10" alder brs. S82E 4.4 ft.
scribing visible, has FS tags

Douglas county tags. BT's were established by OLS 399, Hootman.

Description of monument and accessories established to perpetuate the original location of this corner

Set a 2"x30" iron pipe with brass cap mkd

T20S	R11W
5	
8	
1970	
650	

Set 2 fence posts + 5 ft. east facing south
+ 5 ft. south facing west

#79

REGISTERED OREGON LAND SURVEYOR

JULY 10, 1964 TOM O. McCULLOUGH 650

Office of C.D. SURVEYOR County of DOUGLAS
State of ORE, I hereby certify that the within instrument was filed in this office
for record on the 13 day of MARCH, 1970, at 10 o'clock A.m., (signed)
[Signature] by [Signature] (DEPUTY)
(COUNTY OFFICIAL)

FILED
RECEIVED

MAR 13 1970

COUNTY SURVEYOR
DOUGLAS COUNTY, ORE.