


CERTIFIED RECORD OF LAND CORNER MONUMENTATION

History of original corner establishment:

1/4 corner established in 1892 by W. P. Wright

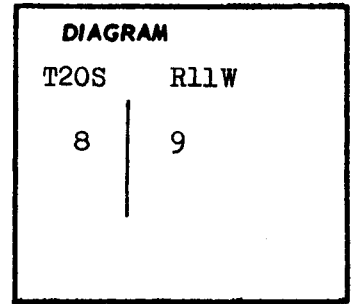

Description of corner evidence found:

Found 1" pipe from which

26" fir stump brs. S74W 4.6 ft. (orig)
face chopped out, scribing visible

Description of monument and accessories established to perpetuate the original location of this corner

Set a 2"x30" iron pipe with brass cap mkd

T20S	R11W
------	------

8		9	1/4
---	--	---	-----

1970
650

from which

18" fir stump brs. N50E 35.0 ft.
scribed 1/4 BT, with tag

Set 2 fence posts with signs + 5.0 ft. ~~east facing south~~
+ 5.0 ft. ~~south facing west~~

#81

REGISTERED
OREGON
LAND SURVEYOR

Tom O. McCullough
JULY 10, 1964
TOM O. McCULLOUGH
650

Office of County of
State of , I hereby certify that the within instrument was filed in this office
for record on the day of; 19....., at o'clockm., (signed)
..... by
(COUNTY OFFICIAL) (DEPUTY)

FILED
RECEIVED

MAR 13 1970

COUNTY SURVEYOR
DOUGLAS COUNTY, ORE.