


CERTIFIED RECORD OF LAND CORNER MONUMENTATION

History of original corner establishment:

The range line between R12W and R11W, the section corner

$\frac{12}{13} | \frac{17}{18}$ was established in 1892 by Harvey Gordon.

Four months later the closing corner was established between $\frac{7}{18}$ which fell south of standard corner.

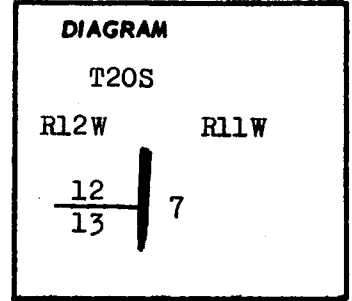

Description of corner evidence found:


Found 1" pipe and old post from which

70" fir brs N51E 17.8 ft.
old face chopped out, with tags

40" fir shell brs. S22W 6.9 ft.

Description of monument and accessories established to perpetuate the original location of this corner

Set a 2"x30" iron pipe with brass cap mkd

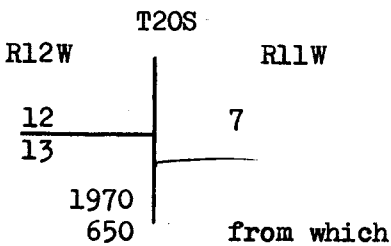

18" spruce brs. N18W 28.7 ft.
scribed S12 R12 BT

6" spruce brs. S20W 27.6 ft.
scribed S13 R12 BT

Set 1 fence post + 5 ft. west facing north

Placed the 1" pipe east of corner.

#82-T20-11
#39-T20-12

REGISTERED
OREGON
LAND SURVEYOR

Tom O. McCullough
JULY 10, 1964
TOM O. McCULLOUGH
650

Office of County of
State of , I hereby certify that the within instrument was filed in this office
for record on the day of , 19....., at o'clockm., (signed)
..... by
(COUNTY OFFICIAL) (DEPUTY)

FILED
RECEIVED

MAR 13 1970

COUNTY SURVEYOR
DOUGLAS COUNTY, ORE.