


FILED
RECEIVED

OCT 29 1970

MORRIS AD COUNTY SURVEYOR
VOL. 12, PG. 18 DOUGLAS COUNTY, OREGON

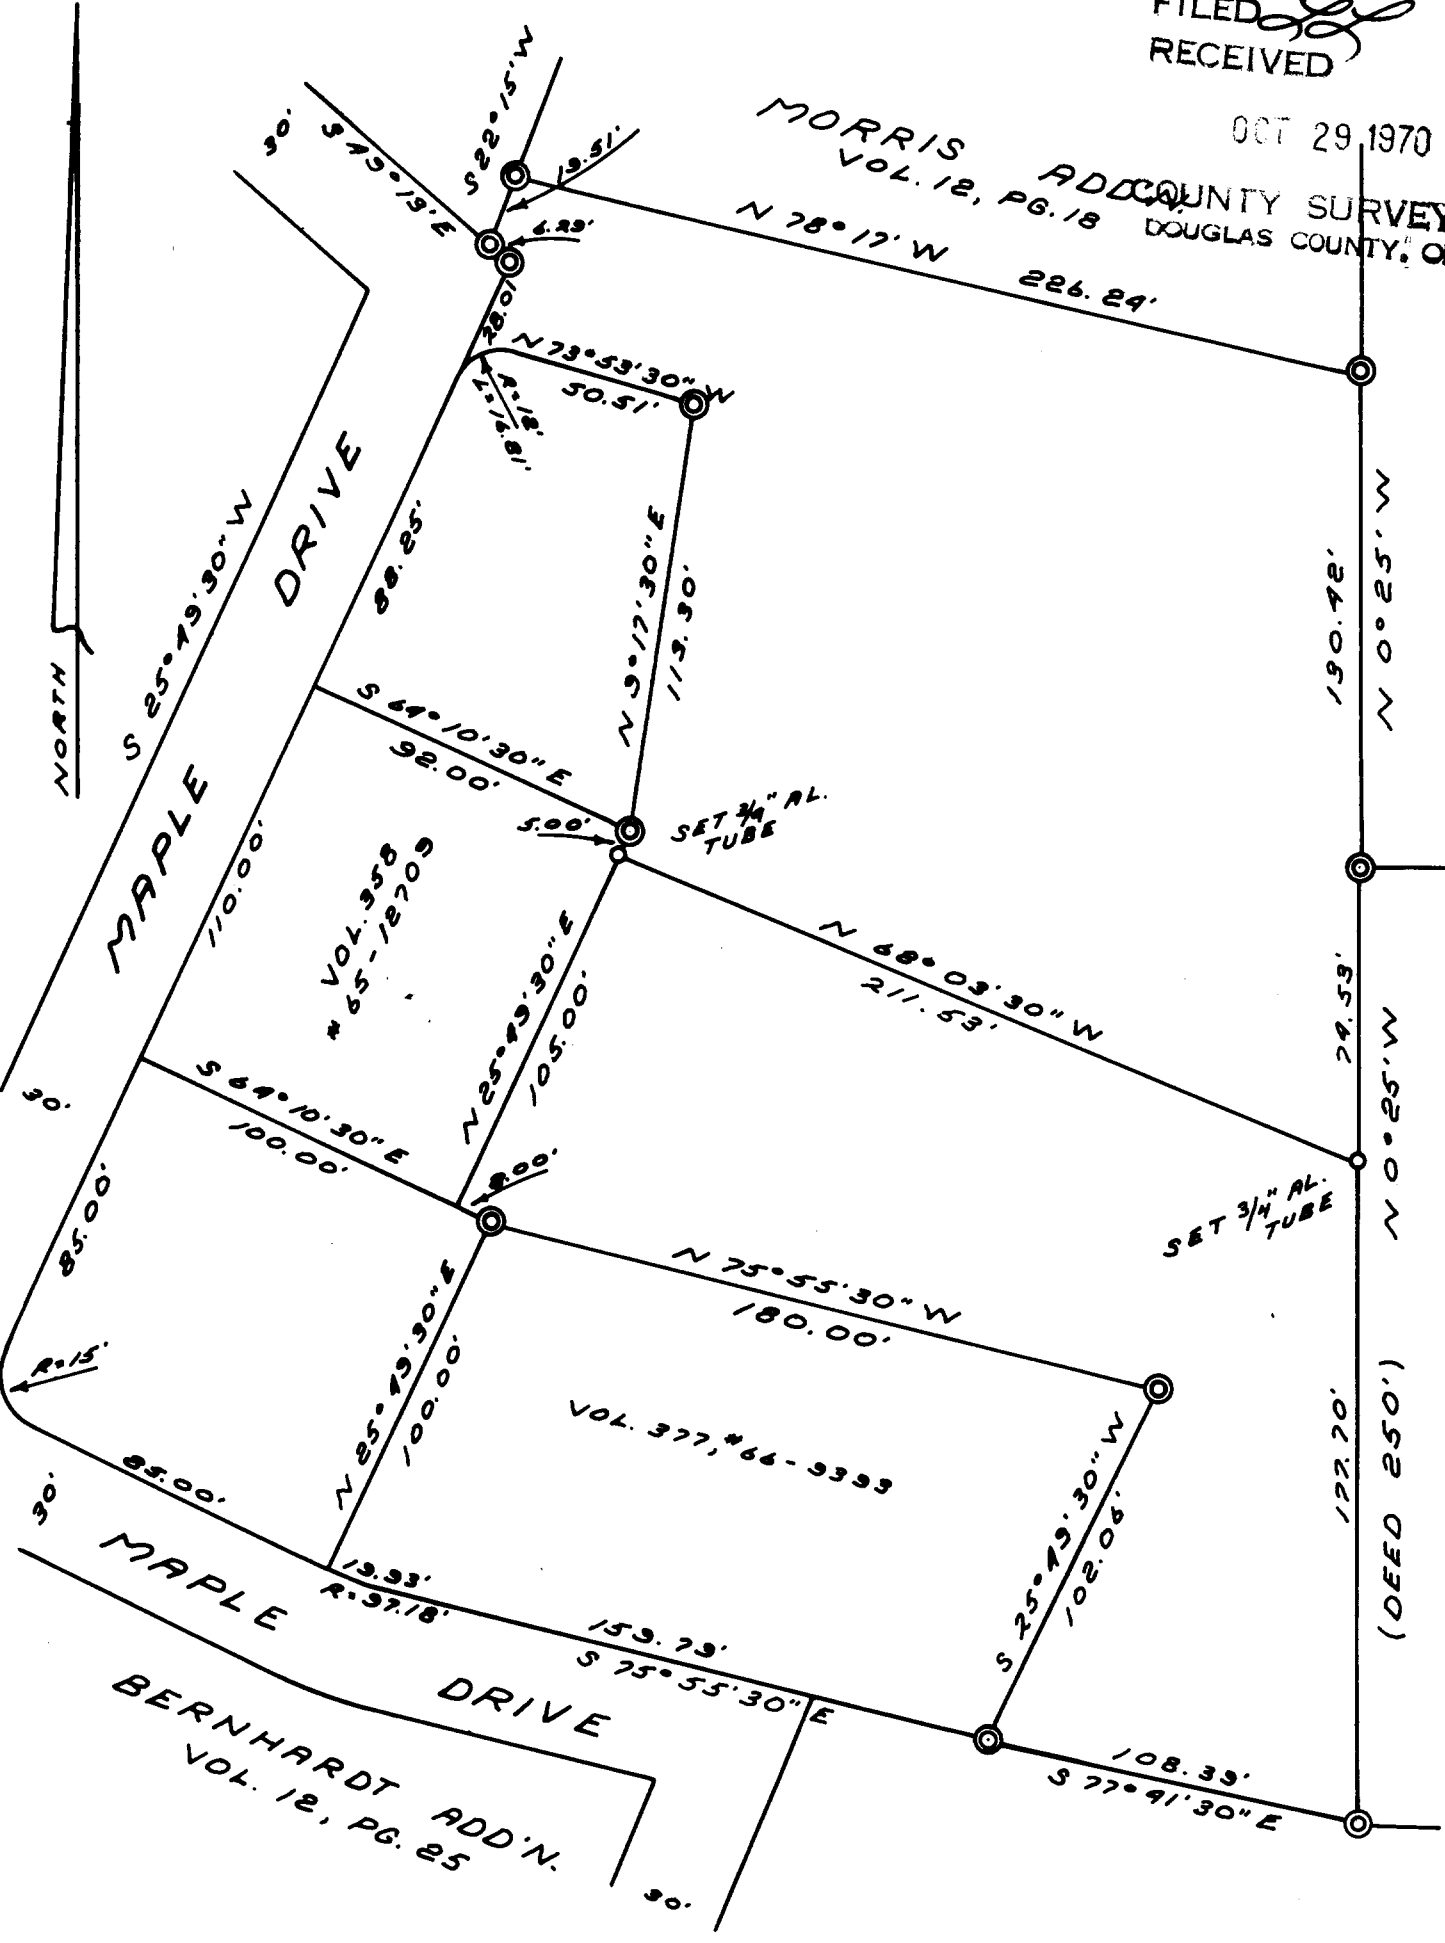

VOL. 287, PG. 184

(DEED 250')

I.P.'S FOUND

REGISTERED
OREGON
LAND SURVEYOR

Richard J. Hintz

MAY 13, 1960
RICHARD J. HINTZ
497

PROPERTY SURVEY

FOR
PAUL BERNHARDT

NW 1/4 SE 1/4, SEC. 4, T22S, R12W
AUG. 1970 SCALE: 1" = 50'

COUNTY SURVEYORS FILE DATA
DO NOT REMOVE FROM OFFICE