


FILED *SL*
RECEIVED

APR 30 1970


COUNTY SURVEYOR
DOUGLAS COUNTY, ORE.

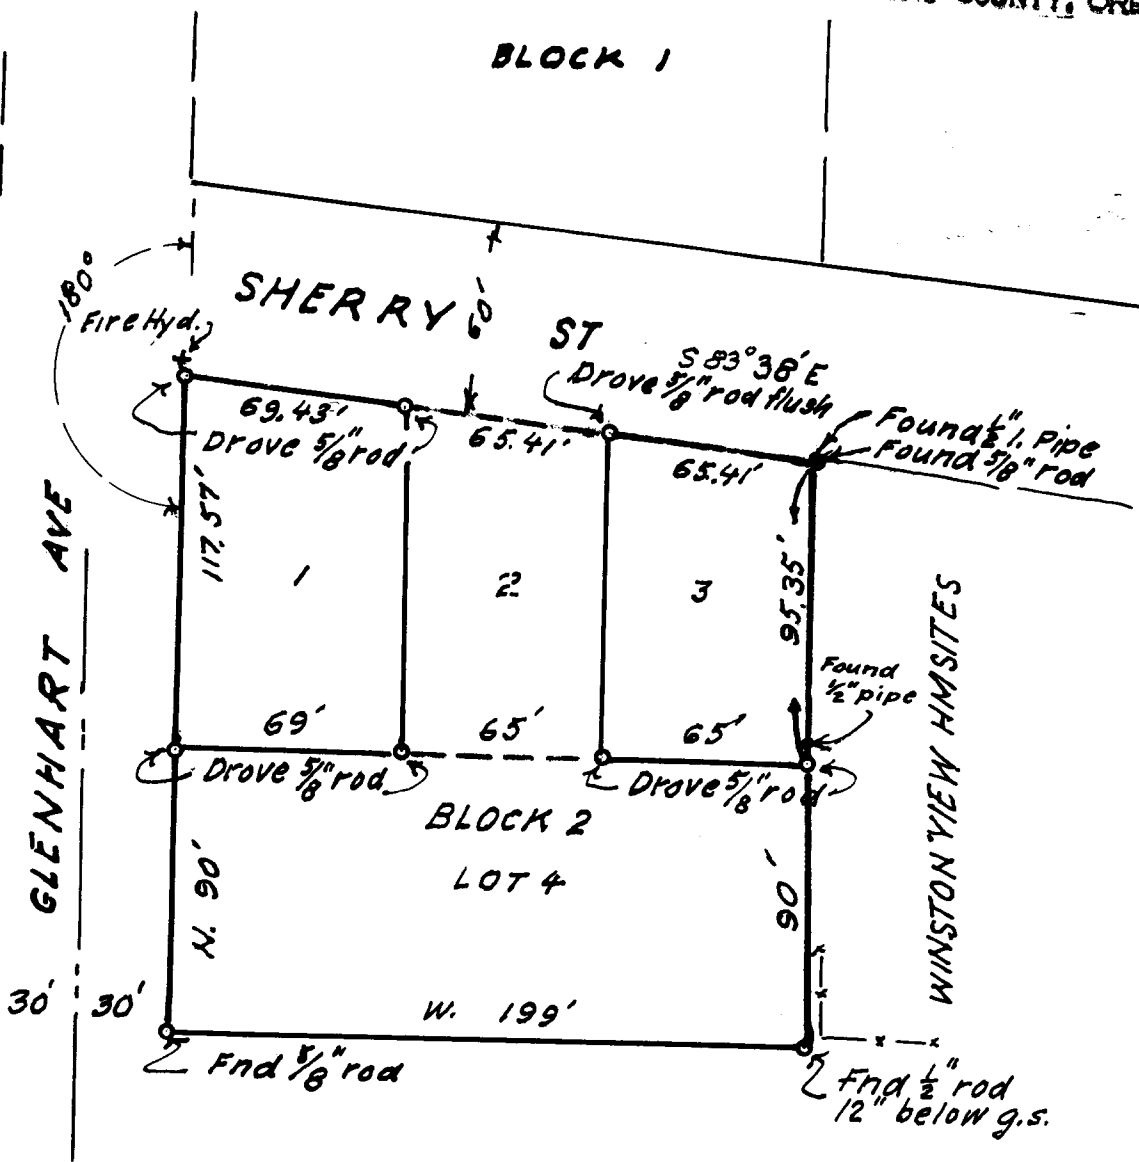

COUNTY SURVEYORS FILE DATA
DO NOT REMOVE FROM OFFICE

CECIL CALLAHAN & WF.
LOTS 1, 3 & 4, BLOCK 2,
CALHOUN ADD. TO CITY OF WINSTON
IN LOT 2, GLEN D. HART TRACT
SEC 21, T.28S; R. 6 W; WIL. MER.
DOUGLAS COUNTY, ORE.

APR 1970 1" = 60'

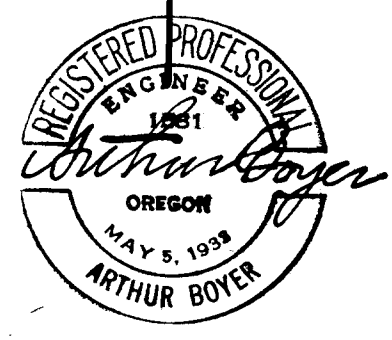

P C.S. File No. 55/146-2