


CERTIFIED RECORD OF LAND CORNER MONUMENTATION

History of original corner establishment:

No Record

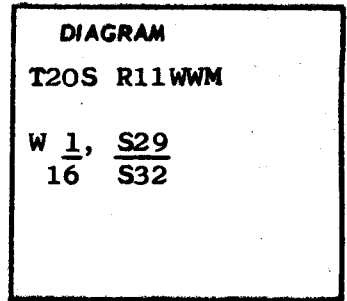

Description of corner evidence found:


None

Description of monument and accessories I established to perpetuate the original location of this corner

I set a 2" x 30" galvanized iron pipe with a brass cap, 24" in the ground.

I stamped the disk .....

From the pipe monument I marked new bearing trees, a 26" fir bears S26°W at 41.5 ft, a 48" fir bears N18°W at 63.5 ft.

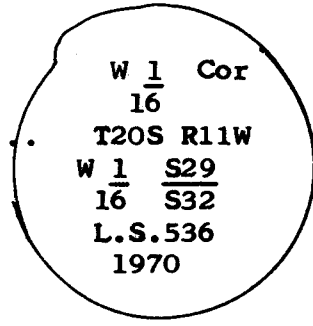

REGISTERED  
OREGON  
LAND SURVEYOR

*Glenn S. Baughman*

JULY 14, 1961  
GLENN S. BAUGHMAN  
536

Office of SURVEYOR County of DOUGLAS

State of Oregon, I hereby certify that the within instrument was filed in this office for record on the 28 day of APRIL, 1970, at 11 o'clock A.m., (signed)

*James W. [Signature]*  
(COUNTY OFFICIAL)

by ..... (DEPUTY)