


CERTIFIED RECORD OF LAND CORNER MONUMENTATION

History of original corner establishment:

1/4 corner was established in 1892 by W. P. Wright

Re-established with brass cap by C.S. in 1969

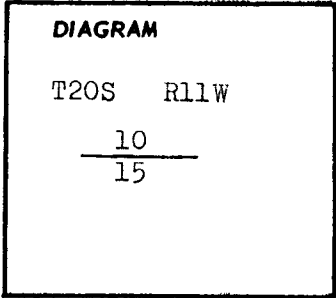

Description of corner evidence found:

Found 1" pipe

Found brass cap mkd

T20S R11W

S10

S15

1969

CS

from which

30" fir stump brs N58W 29.7 ft. - bark scribing visible

40" fir brs. N88E 178.8 ft. - scribing 1/4 S10 CS BT

Description of monument and accessories established to perpetuate the original location of this corner

No new monument set

No new bearing trees

Set a fence post with sign + 5 ft. north facing west

*Added to Ren. # 69, T20-11W
LH*

Office of..... County of.....

State of....., I hereby certify that the within instrument was filed in this office for record on the..... day of....., 19....., at..... o'clock.....m., (signed)

..... by..... (COUNTY OFFICIAL) (DEPUTY)

FILED
RECEIVED

APR 21 1970

COUNTY SURVEYOR
DOUGLAS COUNTY, ORE.

Form R6-7100-57 (9/66)

REGISTERED
OREGON
LAND SURVEYOR

Tom O. McCullough
JULY 10, 1964
TOM O. McCULLOUGH
650

C.S. File No. 55/178-1

470