


CERTIFIED RECORD OF LAND CORNER MONUMENTATION

History of original corner establishment:


Section corner was established in 1892 by W.P. Wright

Re-established with brass cap by C.S. in 1969

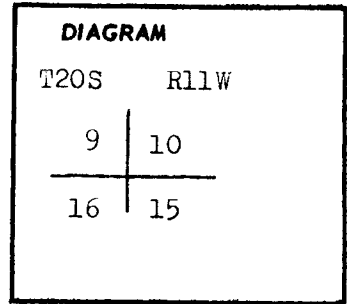

Description of corner evidence found:

Found a brass cap mkd

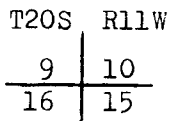

1969

CS from which

8" hemlock stump brs. S62W 9.9 ft. - found reverse scribing - with tag

4" hemlock brs. N76E 13.0 ft. - scribed S10 CS

4" hemlock brs. S29W 14.4 ft. - scribed S16 CS

Description of monument and accessories established to perpetuate the original location of this corner

No new monument set

No new bearing trees.

Set two fence posts with signs + 5 ft. north facing east
+ 5 ft. west facing south

*Added to Ren. #70, T20-11
LL*

Office of County of
State of , I hereby certify that the within instrument was filed in this office
for record on the day of; 19....., at o'clock
..... by
(COUNTY OFFICIAL) (DEPUTY)

REGISTERED
LAND SURVEYOR
TOM O. McCULLOUGH

Tom O. McCullough
JULY 10, 1964
TOM O. McCULLOUGH
650

FILED
RECEIVED

APR 21 1970

COUNTY SURVEYOR
DOUGLAS COUNTY, ORE.

Form R6-7100-57 (9/66)

55/148-24/10