


CERTIFIED RECORD OF LAND CORNER MONUMENTATION

History of original corner establishment:

Corner established by Thiel in 1880 and re-established with brass cap in 1918 by Collier on retracement. New brass cap set in 1967 by C.S.

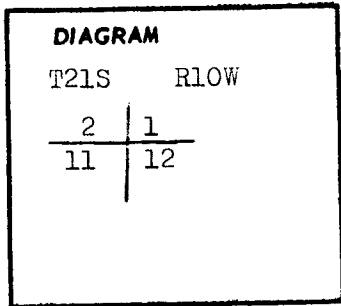

† The NW C.S. BT gone due to landing - the corner had a fire sweep through. I retagged the burned tags.

Description of corner evidence found:

Found brass cap mkd T21S R10W

2	1
11	12

 1967
 CS from which

18" alder (dead) brs. N44 $\frac{1}{4}$ E 8.6 ft. - face rotted away - with tag
 14" alder snag 4' high brs. S52E 8.6 ft. - no scribing - with tag
 15" alder (windthrown) brs. S32W 13.9 ft. - face rotten - with tag
 Found 1918 GLO brass cap alongside of corner. Above set in 1918.

10" hemlock brs. N13E 15.1 ft. - scribing visible - with tag
 14" hemlock brs. S79E 25.6 ft. - scribing visible - with tag
 8" hemlock brs. S10W 36.7 ft. - scribing visible - with tag

Above set in 1967 by C.S.
Description of monument and accessories established to perpetuate the original location of this corner

No new monument set.

Set 1 fence post + 5 ft. north facing east

*Added to Ren. #3, T21-10
 L.L.*

Office of County of
 State of , I hereby certify that the within instrument was filed in this office
 for record on the day of , 19..... , at o'clock
 by
 (COUNTY OFFICIAL) (DEPUTY)

REGISTERED OREGON LAND SURVEYOR

<i>Tom O. McCulloch</i>
JULY 10, 1964 TOM O. McCULLOUGH 650